IREDELL COUNTY HEALTH DEPARTMENT

Statesville Phone TR 3-7271 Mooresville Phone NO 3-1271

PERMIT TO INSTALL SEPTIC TANK

Permit NO. 280 Permit Date Aug 21 1970

706 St Cloud Dr.

Owner HENRY CONRAD Address STATESVILLE, NC.

Installed By Sam Ostwalt Address TROUTMAN, NC.

Location of Property Country Club - SHANNON ACRES


S. CORNER St. Cloud Rd. + LINVILLE Rd.

Tank		Capacity		Length of Lines		Fixtures	
Block	( )	1000	( )	225'	( )	No. of Baths	(2)
Precast	(✓)	1250	(✓)	250'	( )	Dishwasher	( )
		1500	( )	Other 138		Garbage Grdr.	( )
		Other				Other	

NOTIFY HEALTH DEPARTMENT AT LEAST EIGHT HOURS BEFORE TANK IS TO BE INSPECTED.

Final Inspection Aug 21 1970 Approved (✓) Disapproved ( )

Remarks 8' 24" Stone in Nitrification Field.

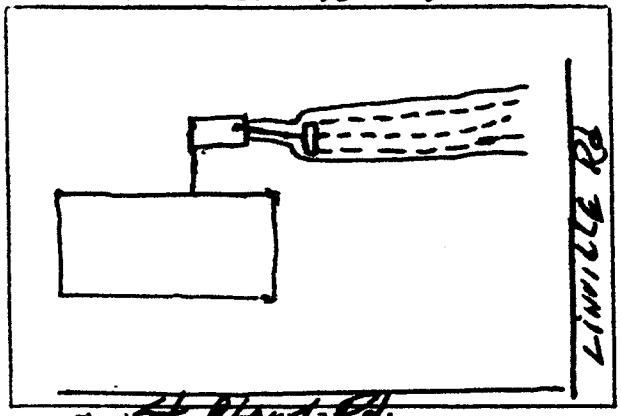

St. Cloud Rd

Sketch of Installation

Sanitarian