IREDELL COUNTY HEALTH DEPARTMENT

Statesville Phone TR 3-7271 Mooresville Phone NO 3-1271

PERMIT TO INSTALL SEPTIC TANK

Permit No. 362 Permit Date 11-12 1971

Owner Mrs John Buonocore JR. Address Statesville

Installed By Raymond Adams Address Hiddenite


Location of Property Out East Broad St to Country Club Turn Rt on St Andrews St go to Sunnindale St Turn Left to 3408

Tank		Capacity		Length of Lines		Fixtures	
Block	( )	1000	( )	225'	( )	No. of Baths	( )
Precast	( )	1250	( )	250'	( )	Dishwasher	( )
		1500	( )	Other 100 ft Filter Bed		Garbage Grdr.	( )
		Other				Other	

NOTIFY HEALTH DEPARTMENT AT LEAST EIGHT HOURS BEFORE TANK IS TO BE INSPECTED.

Final Inspection 19 Approved ( ) Disapproved ( )

Remarks

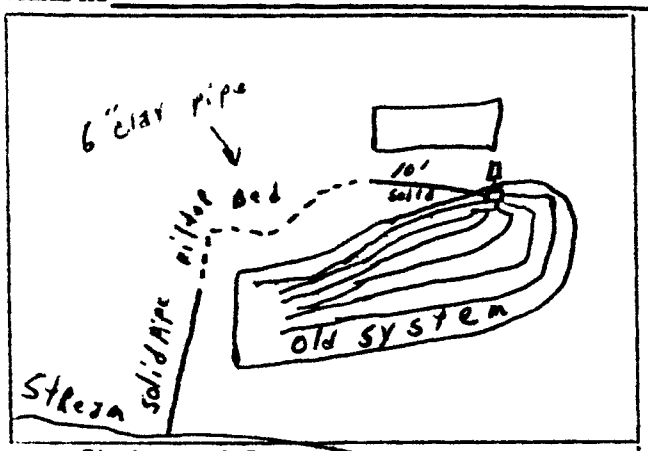

Sketch of Installation

Checked Periodically during two days of installation.

C. S. H.

Sanitarian