IREDELL COUNTY HEALTH DEPARTMENT

Statesville Phone TR 3-7271 Mooresville Phone NO 3-1271

PERMIT TO INSTALL SEPTIC TANK

Permit No. _____ Permit Date 8-20 1971

Owner RICHARD REAVIS Address STATESVILLE, NC

Installed By LACKEY BROS Address STONY POINT, NC

Location of Property EAST Broad St. EXT. -


COUNTRY CLUB - CORNER ST CLOUD RD - JUNNINGDALE DR.

Tank		Capacity		Length of Lines		Fixtures	
Block	( )	1000	( )	225'	( )	No. of Baths	(5)
Precast	( )	1250	( )	250'	( )	Dishwasher	(/)
(SINGLE HOME AEROBIC)		1500	( )	Other		Garbage Grdr.	(/)
		Other				Other	

NOTIFY HEALTH DEPARTMENT AT LEAST EIGHT HOURS BEFORE TANK IS TO BE INSPECTED.

Final Inspection 8-20 19__ Approved (✓) Disapproved ( )

Remarks

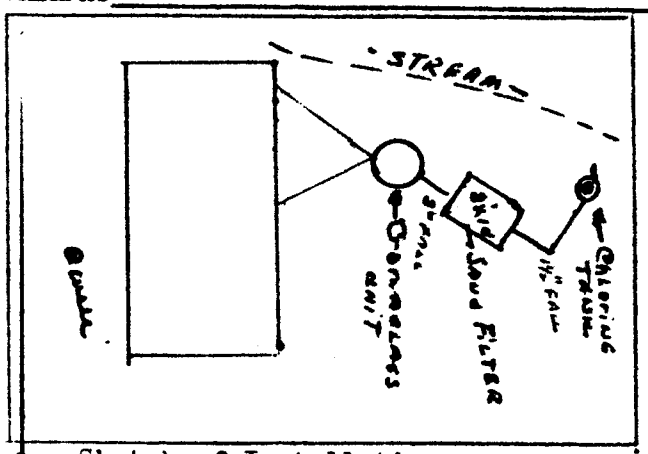

Sketch of Installation

THIS SYSTEM MFG. BY - CROMAGLASS CORP. WILLIAMSPORT, PA.

MODEL NO. CA 610-3M

SERIAL NO. 7971-306

Sanitarian