IREDELL COUNTY HEALTH DEPARTMENT

Statesville Office (704) 878-5305 Mooresville Office (704) 660-3625 PERMIT # 214068

IMPROVEMENT PERMIT / AUTHORIZATION TO CONSTRUCT / OPERATION PERMIT / EXISTING SYSTEM

PIN # 4764313744 3634

APPLICANT: Sammy Deal APPLICANT ADDRESS: 449 Fanjoy Rd Statesville NC

SITE ADDRESS: 453 Fanjoy Rd Statesville NC PHONE: 704-500-1783 ALT. PHONE: N/A

SITE DIRECTIONS: 70 E Tf Fanjoy Lot at end on left

SUBDIVISION: Sammy H Deal SECTION: N/A LOT # 1 LOT AREA: 4.9ac + addition DESIGN FLOW: 250 L.T.A.R.: Ex

Septic Tank Ex (gal) STB Date
Pump Tank (gal) PT Date
Pump Make Model Serial #
Nitrification Fields Ex # Lines Ex Linear Ft: Ex
Trench Width Ex Max. Trench Bottom Depth Ex Gravel Depth Ex

☐ New System ☐ Repair ☐ Expansion System Type: I II III IV V VI
System Description: Existing
Repair System Description:
Maintenance Agreement Required: ☐ YES ☒ NO
☑ GRAVITY ☐ PRESSURE


☐ Residence No. Bedrooms
☒ Business No. Persons
☐ Other No. Employees 10
☑ Slab ☐ Crawl Space
☐ Basement w/plumbing ☐ Basement w/o plumbing

Water Supply: ☑ Private ☐ Public ☐ Community


Comments / Conditions: All building foundations must be 35' from any part of STS

Property lines per Survey Provided.

INITIAL SITE SKETCH

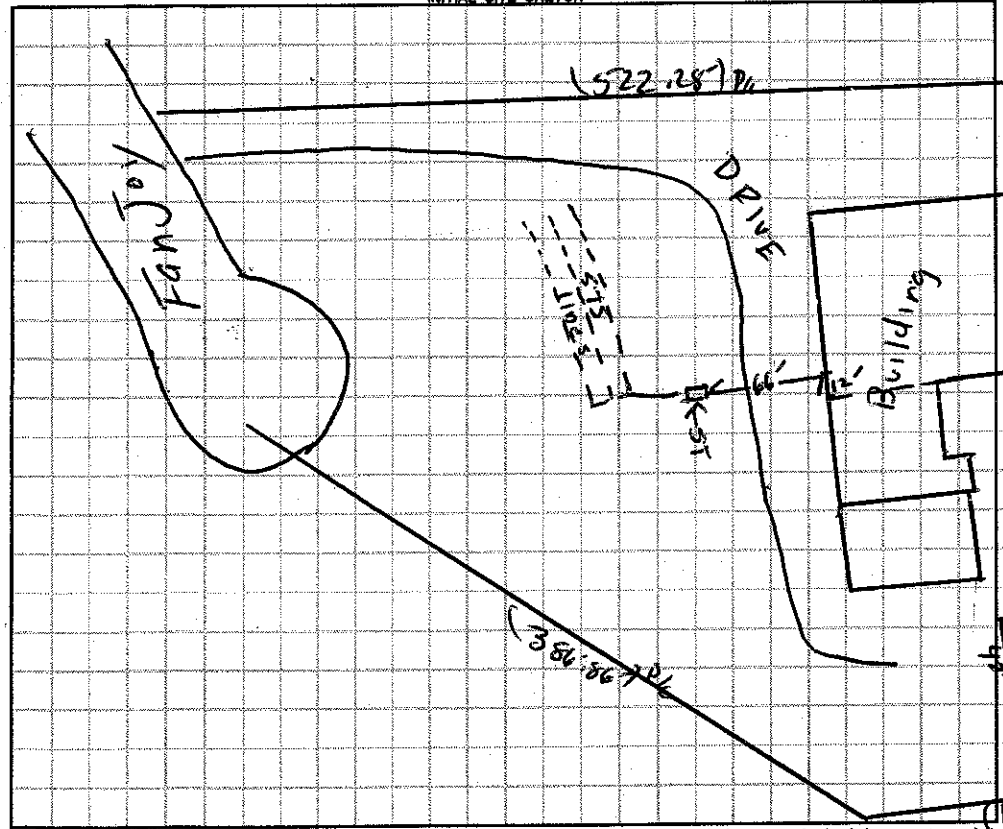

AS BUILT SKETCH

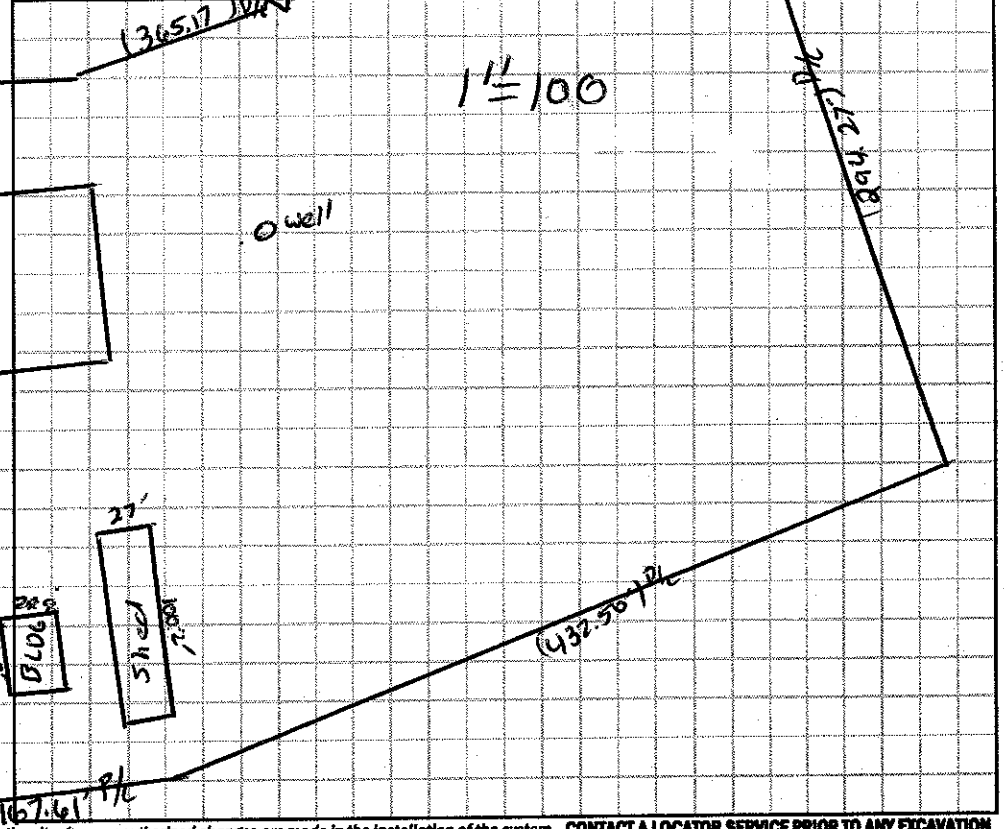

Permit can be suspended or revoked if any false information is supplied toward securing the permit / any unauthorized changes are made to the site / any unauthorized changes are made in the installation of the system. **CONTACT A LOCATOR SERVICE PRIOR TO ANY EXCAVATION**

☐ **IMPROVEMENT PERMIT** *with plat valid without expiration.* ☐ **IMPROVEMENT PERMIT** *with site plan valid for 60 mos.* ☐ **AUTHORIZATION TO CONSTRUCT** *valid for period equal to IMPROVEMENT PERMIT--not to exceed 60 mo.*

Owner / Applicant Signature: Issued w/o signature 10/29/15 Date: Installed by:

IMPROVEMENT PERMIT by: Date: OPERATION PERMIT by: Date:

AUTHORIZATION TO CONSTRUCT by: Date: Existing System Inspected by: David A Lowe Date: 10/29/15

Health Dept. Copy - WHITE Applicant (Final Approval) - YELLOW Applicant (Conditional Approval) - PINK