*THIS PERMIT REPLACES PREVIOUS PERMIT ISSUED 10/29/04.

IREDELL COUNTY HEALTH DEPARTMENT

STATESVILLE 704-878-5305 (CF) MOORESVILLE 704-664-5281

IMPROVEMENT PERMIT / AUTHORIZATION TO CONSTRUCT / OPERATION PERMIT / EXISTING SYSTEM INSPECTION

PERMIT# 138988 PIN# 4764-34-0467 704-902-4857 DATE 11/07/06

OWNER OR APPLICANT JOHNATHAN HEDRICK PHONE: Business 704-657-7226 Home 704-871-0918

ADDRESS 724 OAKDALE DR. STA. NC 28677

LOCATION HWY 64 EAST (R) BELL FARM RD, (R) SKYLAND, (R) CARTERS FARM DR., LOT ON RIGHT @ END,

SUBDIVISION CARTERS FARM BLOCK / SECTION 1 LOT 31 LOT AREA 0.759 AC. SITE CLASS PS DESIGN FLOW 360 GPD L.T.A.R. 0.225 GPD/FT²

Septic Tank: 1,000 Gallons; STB 1010 Date 12-8-1

Pump Tank: ____ Gallons; PT ____ Date ____

Pump Make: ____ Model ____ Serial No. ____

Nitrification Field: No Fields ____ Square Feet 520 to 1600 Linear Feet 400'

No Lines 4 @ 100' Trench Width 36" Trench Bottom Depth 24"

☒ New System ☐ Repair ☐ Expansion System Type: I II III IV V VI

System Description: 25% REDUCTION, GRAVITY

Repair System Description: 50% REDUCT, PUMP L.P.

Maintenance Agreement Required: ☐ Yes ☒ No

☒ House/Mod. Home ☐ Mobile Home ☐ Business ☐ Other

No. Bedrooms 3 No. Persons ____ No. Employees ____


Water Supply: ☐ Individual ☒ Public ☐ Community

Gravel Depth N/A ☒ Gravity ☐ Pressure ☐ Slab ☒ Crawl Space ☐ Basement w/plumbing ☐ Basement wo/plumbing


Comments/Conditions: (1) INSTALL SYSTEM USING 24" TRENCH BOTTOM DEPTH, (2) INSTALL A SUBSURFACE INTERCEPT DRAIN ABOVE DRAINFIELD, START DRAIN AT 36"+ DEPTH ABOVE SYSTEM AND AROUND END OF LINES TO DAYLIGHT AS SHOWN, SOLID PIPE FROM LOWEST LINE TO DITCH.

*SCALE: ~1"=50'

INITIAL SITE SKETCH

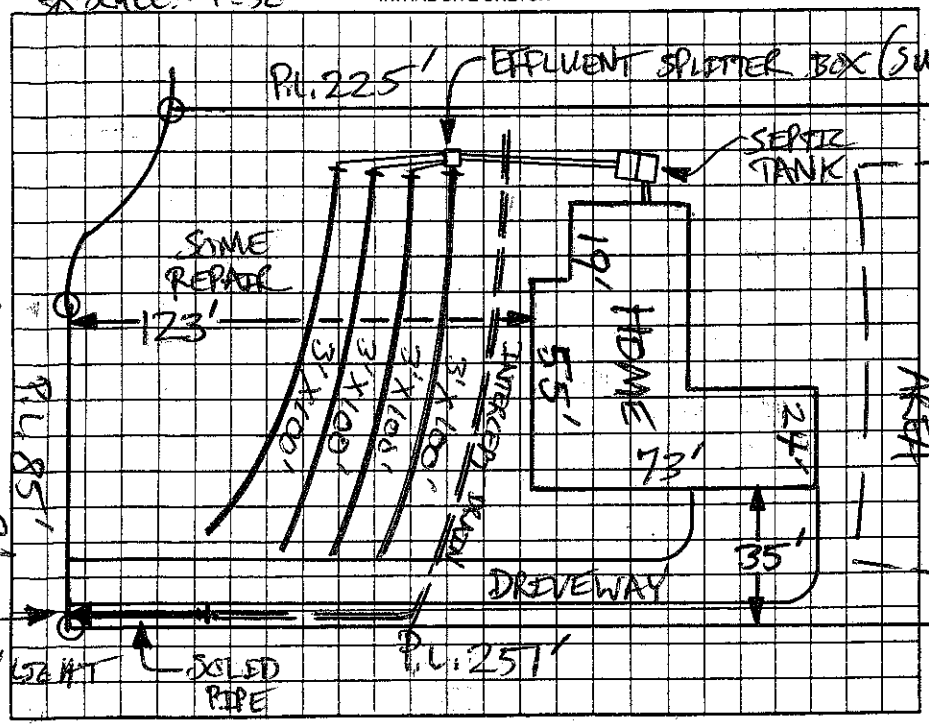

AS BUILT SKETCH

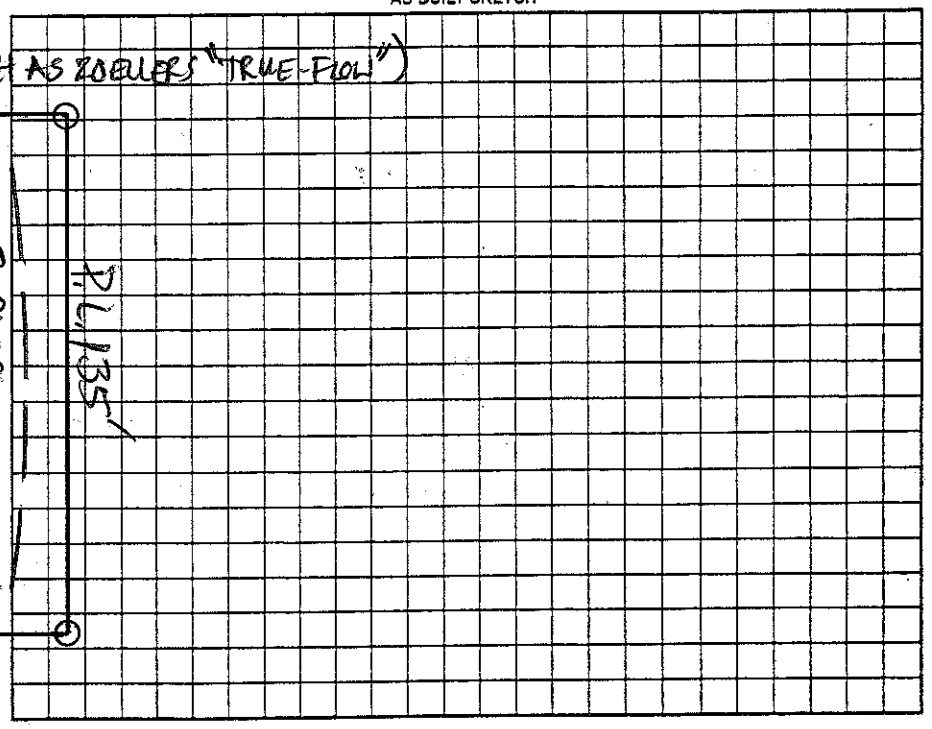

Permit can be suspended or revoked if any false information is supplied toward securing the permit/any unauthorized changes are made to the site/any unauthorized changes are made in the installation of the system. Improvement Permit with plat valid without expiration ☐ Improvement Permit with site plan valid for sixty months ☒ Authorization to Construct is valid for a period equal to that of Improvement Permit – not to exceed sixty months.

Signed: Johnathan Hedrick date 11/8/06

Improvement Permit by: [signature] date 11/07/06

Authorization to Construct by: [signature] date 11/07/06

Installed by: [signature] JOHNATHAN

Operation Permit by: [signature] date 5 June 07

Existing System Inspection by: ____ date ____

HEALTH DEPT. COPY: WHITE OWNER COPY (FINAL): YELLOW OWNER COPY (INITIAL): PINK