IREDELL COUNTY HEALTH DEPARTMENT

STATESVILLE 704-878-5305 MOORESVILLE 704-664-5281

IMPROVEMENT PERMIT / AUTHORIZATION TO CONSTRUCT / OPERATION PERMIT / EXISTING SYSTEM INSPECTION

PERMIT# 79355 PIN# 4764 35 4088 DATE 2-25-99

OWNER OR CONTRACTOR Theresa Webber PHONE: Business _____ Home 528 4215

ADDRESS 221 Grandview Dr. Sta.

LOCATION 64E IR Bell Fm Rd TR Farmwood at ent on Rt.

SUBDIVISION Farmwood BLOCK / SECTION _____ LOT 4 LOT AREA 2.0 acres SITE CLASS RS DESIGN FLOW 360 L.T.A.R. .13

Septic Tank: 1000 Gallons; STB 1012 Date 9-12-99 — ☑ New System ☐ Repair System Type: I II III IV V VI

Pump Tank: _____ Gallons; PT _____ Date _____ — System Description: Conv. Gravity

Pump Make: _____ Model _____ Serial No. _____ — Repair System Description: Pump To Dist Box

Nitrification Field: No Fields 1 Square Feet 1200 Linear Feet 400 — Maintenance Agreement Required: ☐ Yes ☑ No

No Lines 3 Trench Width 36" Max Trench Bottom Depth 36" Gravel Depth 12"

☑ House/Mod. Home No. Bedrooms 3
☐ Mobile Home No. Bathrooms 2½
☐ Business No. Employees ____
☐ Other ____


☐ Slab ☐ Crawl Space ☑ Basement w/plumbing ☐ Basement wo/plumbing

Water Supply: ☑ Individual ☐ Public ☐ Community


Comments/Conditions:

Comments/Conditions: Same as initial Sketch

INITIAL SITE SKETCH

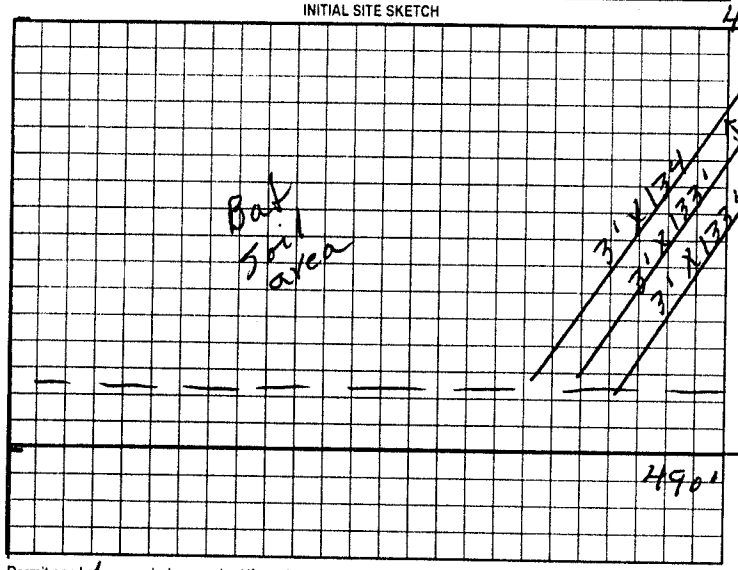

AS BUILT SKETCH

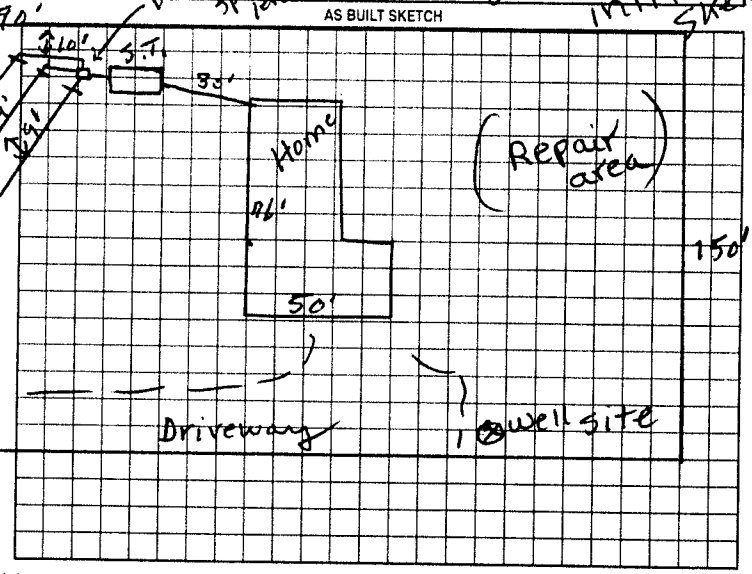

Permit can be suspended or revoked if any false information is supplied toward securing the permit/any unauthorized changes are made to the site/any unauthorized changes are made in the installation of the system. Improvement Permit with plat valid without expiration. Improvement Permit with site plan valid for sixty months. Authorization to Construct is valid for a period equal to that of Improvement Permit – not to exceed sixty months.

Signed: Stephen M. Smoot date _____ Installed by: David Yountz

Improvement Permit by: F. C. Moore date 2-25-99 Operation Permit by: F. C. Moore date 12-3-99

Authorization to Construct by: F. C. Moore date 2-25-99 Existing System Inspection by: _____ date _____

HEALTH DEPT. COPY: WHITE OWNER COPY (FINAL) YELLOW OWNER COPY (INITIAL) PINK