IREDELL COUNTY HEALTH DEPARTMENT

STATESVILLE 704-878-5305 MOORESVILLE 704-664-5281

IMPROVEMENT PERMIT / AUTHORIZATION TO CONSTRUCT / OPERATION PERMIT / EXISTING SYSTEM INSPECTION

PERMIT# 133550 PIN# 4764353397 9437 DATE 2-14-06

OWNER OR CONTRACTOR Elstar Homes PHONE: Business 704-883-9995 Home

ADDRESS Box 423

LOCATION 64 E (R) Bell Farm Rd (R) Skyland (R) Winefield property on left

SUBDIVISION Cartel Farm BLOCK / SECTION 1 LOT 45 LOT AREA .702 SITE CLASS B DESIGN FLOW 360 L.T.A.R. .25

Septic Tank: 1000 Gallons; STB Date

Pump Tank: Gallons; PT Date

Pump Make: Model Serial No.

Nitrification Field: No Fields Square Feet 1440 Linear Feet 360

No Lines 8 Trench Width 36" Max Trench Bottom Depth 36" Gravel Depth N/A

☐ New System ☐ Repair System Type: (I) II, III, IV, V, VI

System Description: 25% Reduction

Repair System Description: LPP

Maintenance Agreement Required: ☐ Yes ☐ No

☒ House/Mod. Home No. Bedrooms 3

☐ Mobile Home No. Bathrooms

☐ Business No. Employees

☐ Other

☐ Slab ☐ Crawl Space ☐ Basement w/plumbing ☐ Basement wo/plumbing

Water Supply: ☐ Individual ☒ Public ☐ Community


Comments:/Conditions:

Maintain all setback
Install on Contour


Comments:/Conditions:

Use T-flow divider to 2 distribution boxes for equal distribution

INITIAL SITE SKETCH

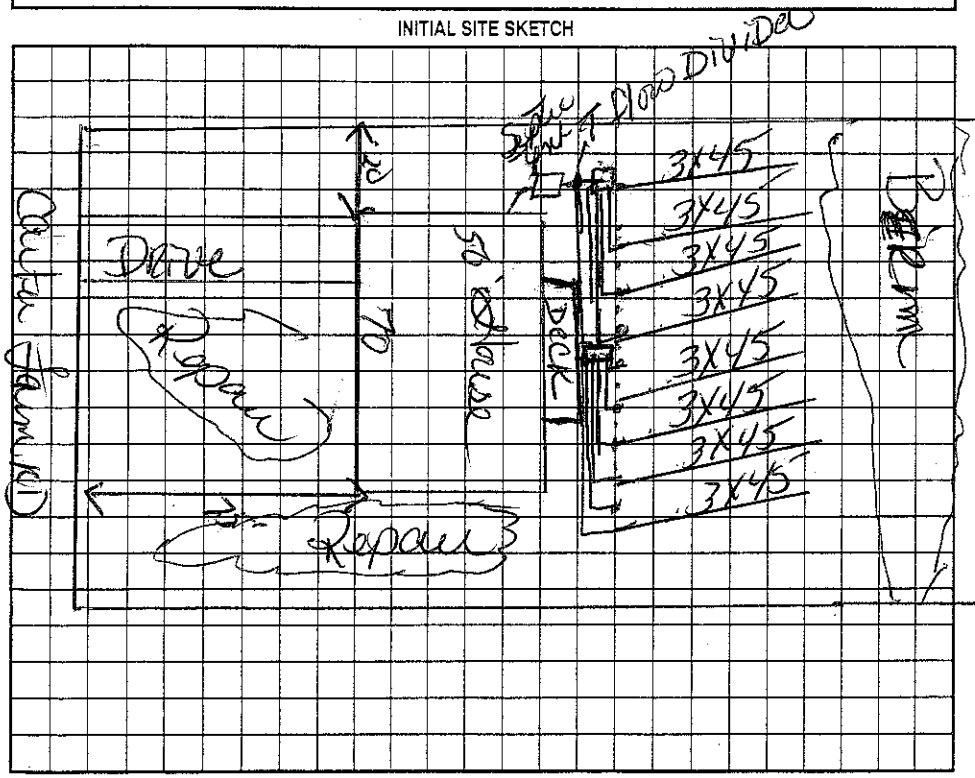

AS-BUILT SKETCH

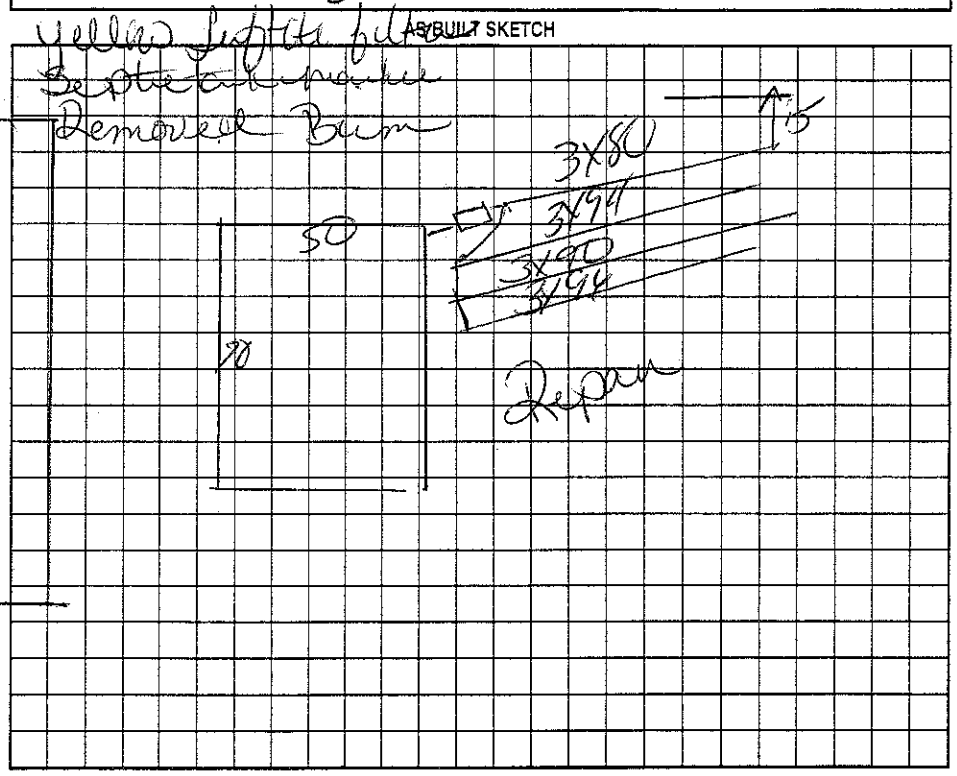

Permit can be suspended or revoked if any false information is supplied toward securing the permit/any unauthorized changes are made to the site/any unauthorized changes are made in the installation of the system. Improvement Permit with plat valid without expiration. Improvement Permit with site plan valid for sixty months. Authorization to Construct is valid for a period equal to that of Improvement Permit – not to exceed sixty months.

Signed: date 2-14-06 Installed by: Craig Thompson

Improvement Permit by: date 2-14-06 Operation Permit by: date 1-11-07

Authorization to Construct by: date 2-14-06 Existing System Inspection by: date

HEALTH DEPT. COPY: WHITE OWNER COPY (FINAL): YELLOW OWNER COPY (INITIAL): PINK