IREDELL COUNTY HEALTH DEPARTMENT

Statesville Phone TR 3-7271 Mooresville Phone NO 3-1271

PERMIT TO INSTALL SEPTIC TANK

Permit No. 380 Permit Date 11-17 1971

Owner Tommy Johnson Address Statesville

Installed By Yarbo Septic Tank Address Stony Point


Location of Property Country Club Section Near Richard Reid's House.

Tank		Capacity		Length of Lines		Fixtures	
Block	( )	1000	( )	225'	( )	No. of Baths	(2)
Precast	(4)	1250	(4)	250'	( )	Dishwasher	( )
		1500	( )	Other 300		Garbage Grdr.	( )
		Other				Other	

NOTIFY HEALTH DEPARTMENT AT LEAST EIGHT HOURS BEFORE TANK IS TO BE INSPECTED.

Final Inspection 19 Approved ( ) Disapproved ( )

Remarks (900 Square ft.) 100 ft long 9 ft. wide.

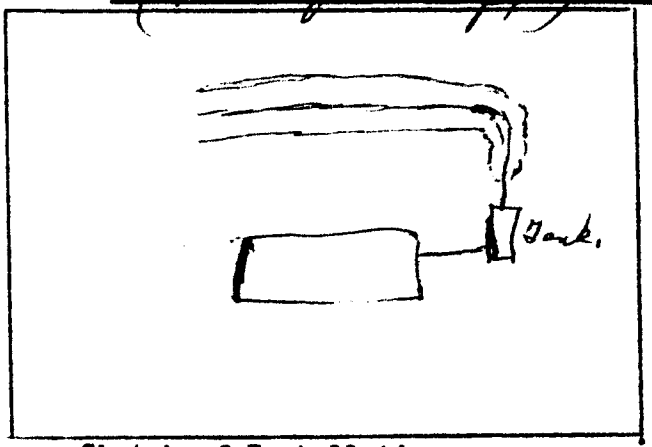

Not checked

Sketch of Installation

Sanitarian