IREDELL COUNTY HEALTH DEPARTMENT

Statesville Phone TR 3-7271 Mooresville Phone NO 3-1271

PERMIT TO INSTALL SEPTIC TANK

Permit No. 137 Permit Date 9-13 19 72

Owner Johnson Builders Address Statesville

Installed By Harlu Lackey Address Stony Point N.C.

Location of Property New Country Club Section

St Cloud Drive - House on Left


Lot # 228

Tank		Capacity		Length of Lines		Fixtures	
Block	( )	1000	( )	225'	( )	No. of Baths	(3)
Precast	(✓)	1250	(✓)	250'	( )	Dishwasher	( )
		1500	( )	Other 300		Garbage Grdr.	( )
		Other		900 sq ft		Other	

NOTIFY HEALTH DEPARTMENT AT LEAST EIGHT HOURS BEFORE TANK IS TO BE INSPECTED.

Final Inspection 9-13 1972 Approved (✓) Disapproved ( )

Remarks Well 90' from Tank.

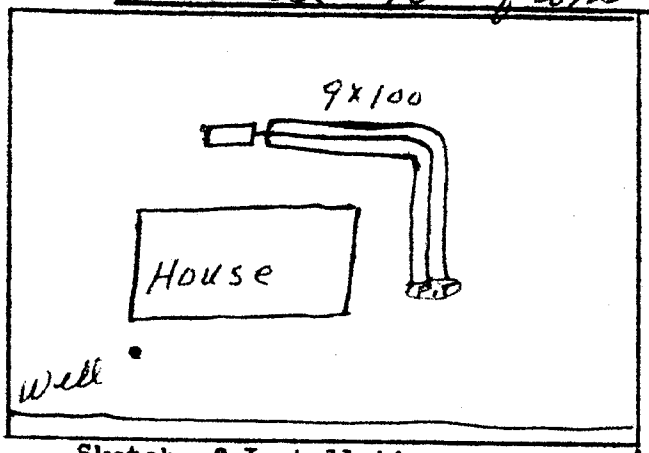

Sketch of Installation

Pit at end of lines with 8 ton stone used

E. G. Stevenson

Sanitarian