IREDELL COUNTY HEALTH DEPARTMENT

STATESVILLE 704-878-5305 MOORESVILLE 704-664-5281

IMPROVEMENT PERMIT / AUTHORIZATION TO CONSTRUCT / OPERATION PERMIT / EXISTING SYSTEM INSPECTION

PERMIT# 12724 PIN# 4764-39-7763 6414 DATE 5-19-05

OWNER OR CONTRACTOR ROBERT MUNDAY PHONE: Business 828-652-0692 Home 828-655-1235

ADDRESS 130 HERITAGE HILL LANE MARION, N.C. 28752

LOCATION 64 EAST @ BELL FARM @ MBOX # 278. WAY BACK IN THE WOODS

SUBDIVISION _____ BLOCK / SECTION _____ LOT _____ LOT AREA 23.45 AC SITE CLASS. PS DESIGN FLOW 360 L.T.A.R. .3

Septic Tank: 1000 Gallons; STB 100 Date 9-23-04
Pump Tank: _____ Gallons; PT _____ Date _____
Pump Make: _____ Model _____ Serial No. _____
Nitrification Field: No Fields 1 Square Feet EQ=1200' Linear Feet 300'
No Lines 2x150' Trench Width 36" Max Trench Bottom Depth 24" Gravel Depth N/A

☒ New System ☐ Repair System Type: I, II, III, IV, V, VI
System Description: 6" 25% REDUCT
Repair System Description: SAME / PUMPED
Maintenance Agreement Required: ☐ Yes ☒ No

☒ House/Mod. Home No. Bedrooms 3
☐ Mobile Home No. Bathrooms 3½
☐ Business No. Employees ____
☐ Other _____
☐ Slab ☐ Crawl Space ☒ Basement w/plumbing ☐ Basement wo/plumbing

Water Supply: ☒ Individual ☐ Public ☐ Community
WELL

Comments:/Conditions: (1) NOTE MAXIMUM TRENCH BOTTOM DEPTH
(2) INSTALL LINES ON CONTOURS

Comments:/Conditions: Polylock Filter Tee

INITIAL SITE SKETCH

SEE ATTACHED SITE PLAN
SUBMITTED BY ASHLEY ROLLINS
"FAST TRACK"

AS BUILT SKETCH

LSS
Installed
AS
Drawn on Site plan


Permit can be suspended or revoked if any false information is supplied toward securing the permit/any unauthorized changes are made to the site/any unauthorized changes are made in the installation of the system. Improvement Permit with plat valid without expiration. Improvement Permit with site plan valid for sixty months. Authorization to Construct is valid for a period equal to that of Improvement Permit – not to exceed sixty months.

Signed: Robert S. Munday date 5-23-05 Installed by: Derrick Barnes

Improvement Permit by: _____ date 5-19-05 Operation Permit by: _____ R.S. date 5 May 06

Authorization to Construct by: _____ date 5-19-05 Existing System Inspection by: _____ date _____

HEALTH DEPT. COPY: WHITE OWNER COPY (FINAL): YELLOW OWNER COPY (INITIAL): PINK

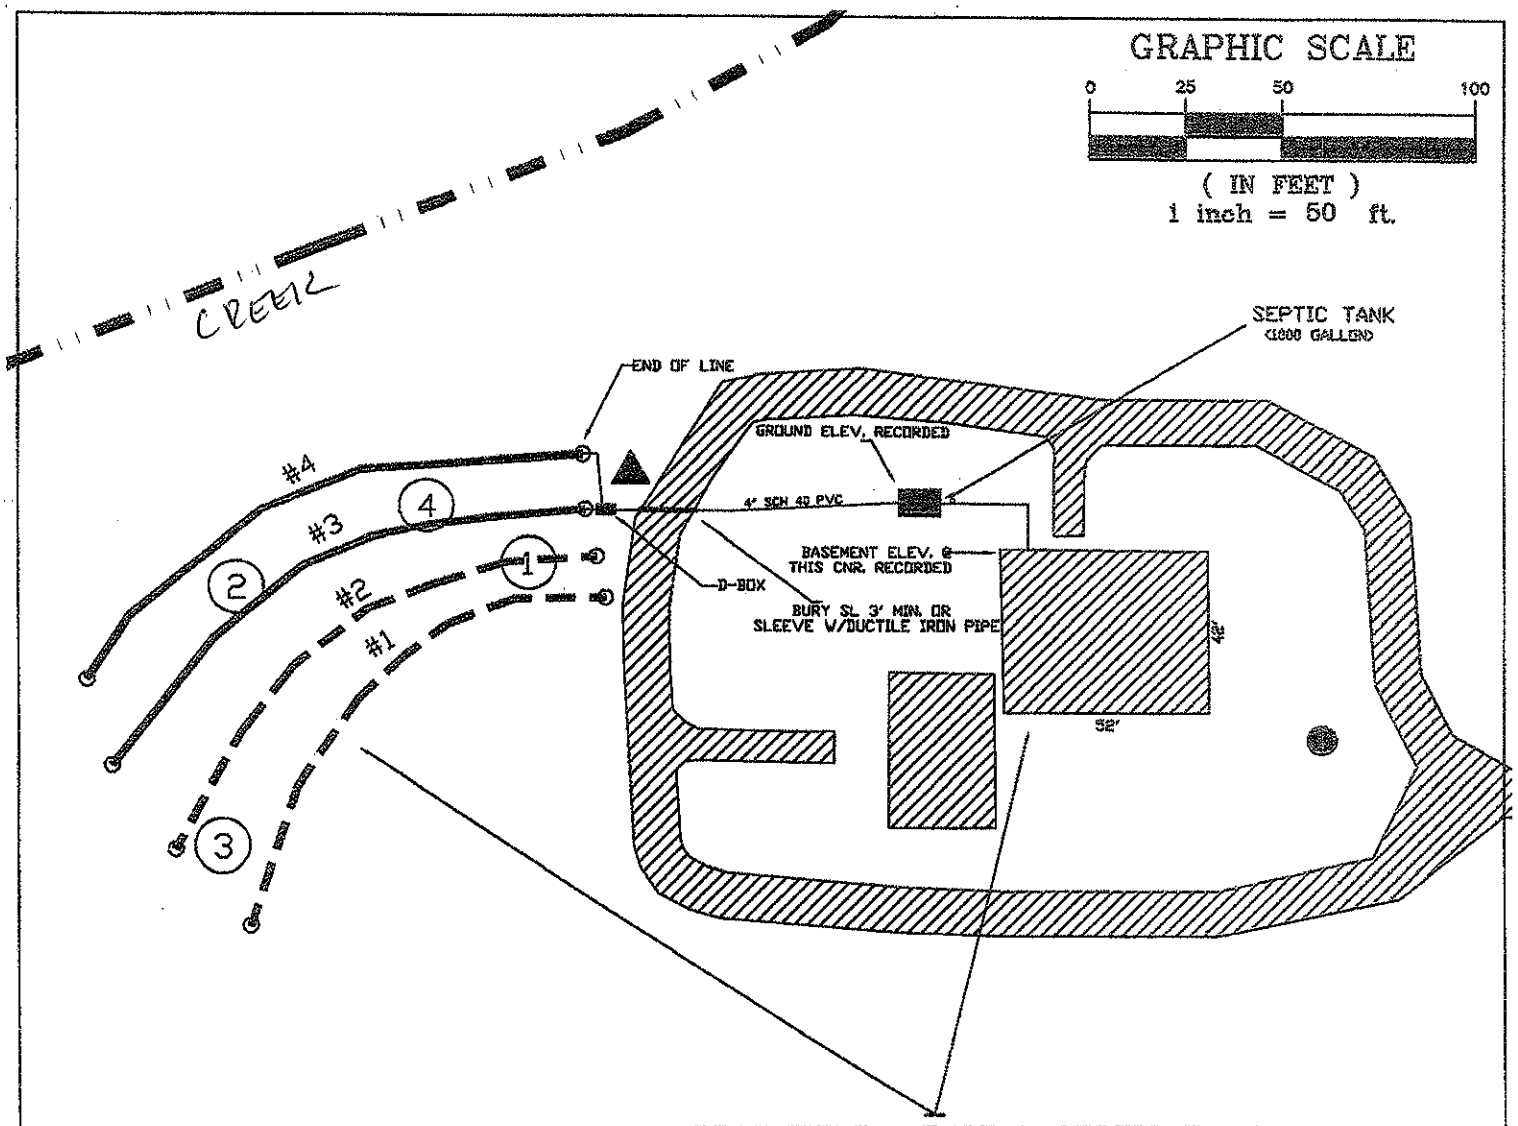

LINE	COLOR	ELEV.	LENGTH
TBM		100.0	
ST		107.5	
HSE CNR		108.1	
#1	GREEN	106.3	150'
#2	WHITE	105.0	150'
#3	RED	103.5	150'
#4	BLUE	101.8	150'

LEGEND

- (S) Boring locations.
- House & driveway location.
- System lines.
- Repair lines.
- Well location.
- Temporary Bench Mark (TBM); Nail in Oak.
- Perennial Stream

ROLLANS SOIL & ENVIRONMENTAL SERVICES
2120 GRAHAM ROAD
MOUNT ULLA, NC 28125
PHONE/FAX: (704) 276-0989
ASHLEY ROLLANS, NC LICENSED SOIL SCIENTIST
MOBILE: (704) 746-5046
EMAIL: ROLLANSFORTC@AOL.COM

SHEET TITLE:
"FAST TRACK" EVALUATION

PROJECT NAME:
BOBBY MURRAY
- BELL FARM ROAD 22.8 AC -
IREDELL COUNTY, NORTH CAROLINA
MAY 2005

S.A.R. | 05-3106 | PROJECT NO.
S.A.R. | PROJECT MGR.
DRAWN BY | S.A.R.
FIELD WORK | S.A.R.
BAR SCALE ON MAP | SCALE
FILE | S.A.R.2005\05-3106