IREDELL COUNTY HEALTH DEPARTMENT

Mr. Ralph Carlson on Pc. 52023

STATESVILLE 704-878-5305 MOORESVILLE 704-664-5201

IMPROVEMENT PERMIT / CERTIFICATE OF COMPLETION / OPERATION PERMIT / EXISTING SYSTEM INSPECTION

PROPERTY DESCRIPTION NO. 1912 DATE 6-27-94 TAX MAP NO. 5N-A-167 Watershed: ☐ Yes ☐ No

OWNER OR CONTRACTOR Calvin Rayson Sta.

ADDRESS Rt 15 PHONE: Business _____ Home 878-2224

LOCATION 64 E to Bell Fen Rd TR Fawnbrook Trailer on left

SUBDIVISION Fawnbrook BLOCK / SECTION _____ LOT _____ LOT AREA 2.0 Acres SITE CLASS. PS DESIGN FLOW 360 C.T.A.R. .35

Septic Tank: 1000 Gallons; SIB 1012 Date 9-11-74

Pump Tank: _____ Gallons; PT _____ Date _____

Pump Make: _____ Model _____ Serial No. _____

Initiation Field: No Fields 4 Square Feet 1035 Linear Feet 345

No Lines 3 Trench Width 3.0 ft Max Trench Bottom Depth 3.0 ft Gravel Depth 1.0 ft ☐ Slab ☐ Crawl Space ☐ Basement w/plumbing ☐ Basement w/o plumbing

Current System ☐ Repair System Type: I (II, III, IV, V, VI)

System Description: Conv. Gravity

Repair System Description: II

Maintenance Agreement Required: ☐ Yes ☐ No

☐ House/Mod. Home No. Bedrooms 3

☐ Mobile Home No. Bathrooms 2½

☐ Business No. Employees _____


☐ Other _____

Water Supply: ☐ Individual ☐ Community ☐ Public

Comments: 24'x24' Garage Addition

Comments:

INITIAL SITE SKETCH

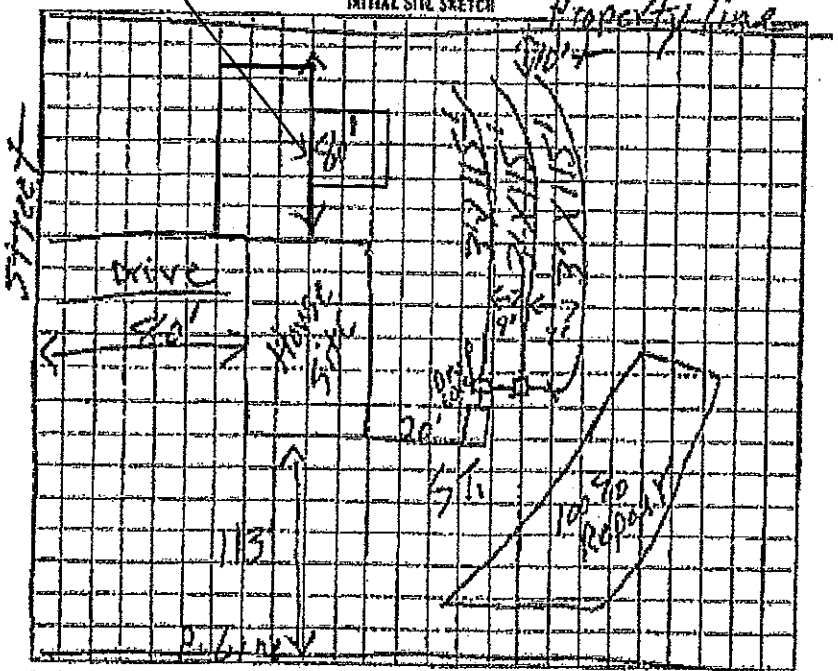


AS BUILT SKETCH

Location of the proposed 24'X24' Garage Add. addition does not appear to impact the existing on-site septic system or well.**NOTE: _____

Josh Henderson REHS Date: 7-28-94

ICHD-Environmental Health Division

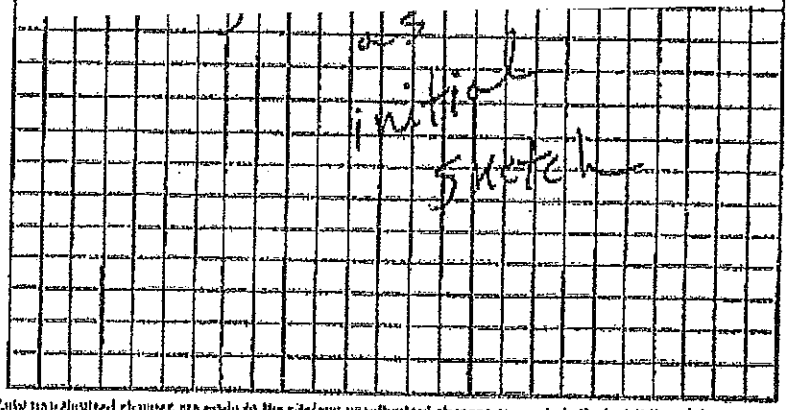

I understand that this permit can be suspended or revoked if any false information is supplied toward securing the permit, any unqualified changes are made to the site, any unauthorized changes are made in the installation of the system. Improvement Permit is valid for 60 months from date of issuance.

Signed: X Jeffrey C. Greene

Improvement Permit by: E.C. Moore date 6-27-94

Existing System Inspection by _____ date _____

Installed by: Donald Lackey

Certificate of Completion by: E.C. Moore date 11-17-74

Operation Permit by _____ date _____

LS 8 0 0 0