IREDELL COUNTY HEALTH DEPARTMENT

STATESVILLE 704-878-5305 MOORESVILLE 704-664-5281

IMPROVEMENT PERMIT / AUTHORIZATION TO CONSTRUCT / OPERATION PERMIT / EXISTING SYSTEM INSPECTION

PERMIT# 20857/80586 PIN# 5m-A-166 PT Taxmap DATE 6-3-99

OWNER OR CONTRACTOR Rick Brewer PHONE: Business 902 0911 Home

ADDRESS 254 Farmwood Drive

LOCATION 6 mi E TR Bell Farm Rd TR Farmwood DR on RIGHT beside large concrete Entrance way

SUBDIVISION BLOCK / SECTION LOT LOT AREA 150' X 500' SITE CLASS PS DESIGN FLOW 368 L.T.A.R. .3

Septic Tank: 1000 Gallons; STB 620 Date 10-1-99

Pump Tank: Gallons; PT Date

Pump Make: Model Serial No

Nitrification Field: No Fields 1 Square Feet 1200 Linear Feet 400

No Lines 3 Trench Width 36" Max Trench Bottom Depth 36" Gravel Depth 12"

☑ New System ☐ Repair System Type: ☐ I ☑ III, IV, V, VI

System Description: conv. Gravity

Repair System Description: Pump To 35% Rd.

Maintenance Agreement Required: ☐ Yes ☐ No

☐ House/Mod. Home No. Bedrooms 3

☐ Mobile Home No. Bathrooms 2 1/2

☐ Business No. Employees

☐ Other


☐ Slab ☐ Crawl Space ☑ Basement w/plumbing ☐ Basement wo/plumbing

Water Supply: ☑ Individual ☐ Public ☐ Community

Comments/Conditions: (Jeff Horne Property)

Comments/Conditions: Installed same as initial sketch JCM 10-4-99

INITIAL SITE SKETCH

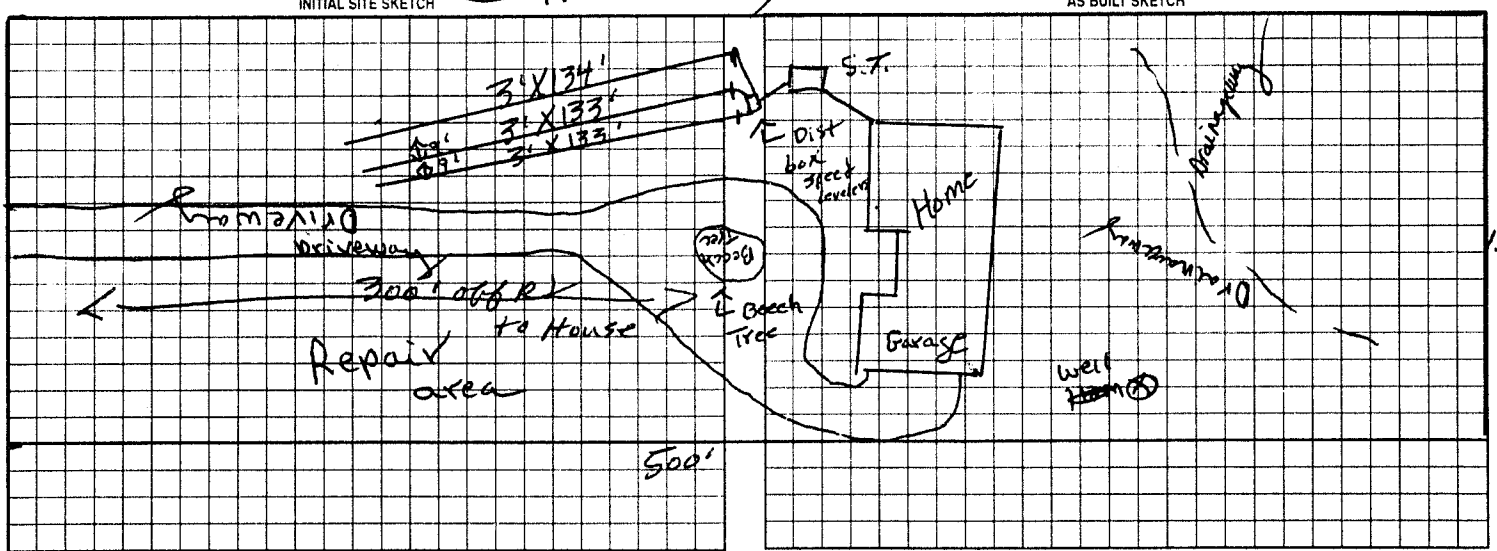

AS BUILT SKETCH

Permit can be suspended or revoked if any false information is supplied toward securing the permit/any unauthorized changes are made to the site/any unauthorized changes are made in the installation of the system. Improvement Permit with plat valid without expiration. Improvement Permit with site plan valid for sixty months. Authorization to Construct is valid for a period equal to that of Improvement Permit – not to exceed sixty months.

Signed: [signature] date 8-19-99 Installed by: Barry Sigmon

Improvement Permit by: P.C. Moore date 6-3-99 Operation Permit by: P.C. Moore date 4-24-00

Authorization to Construct by: P.C. Moore date 6-3-99 Existing System Inspection by: date

HEALTH DEPT. COPY WHITE OWNER COPY (FINAL) YELLOW OWNER COPY (INITIAL) PINK