IREDELL COUNTY HEALTH DEPARTMENT

Statesville Phone TR 3-7271 Mooresville Phone NO 3-1271

PERMIT TO INSTALL SEPTIC TANK

Permit NO. _____ Permit Date 4-2-60 1960

Owner Calvin Costner Address Bell Rd. Rt 6 Mx E.

Installed By C Hoke Address R7.


Location of Property right on Bell Rd. at Beaver Store - 6 Mx E. go about 1 mile dirt road to right at work. Last on dead end

Tank		Capacity		Length of Lines		Fixtures	
Block	( )	800	( )	150'	( )	No. of Baths	(4)
Precast	(✓)	900	( )	175'	( )	Dishwasher	( )
		1000	( )	200'	(✓)	Garbage Grdr.	( )
		1100	( )	225'	( )	Auto-Washer	( )
		1200	( )	250'	( )	Other	( )
		Other 1250		Other _____			

NOTIFY HEALTH DEPARTMENT AT LEAST EIGHT HOURS BEFORE TANK IS TO BE INSPECTED.

Final Inspection 4-2-60 19__ Approved ( ) Disapproved ( )

Remarks Self cont. Mt for washer - well 200'

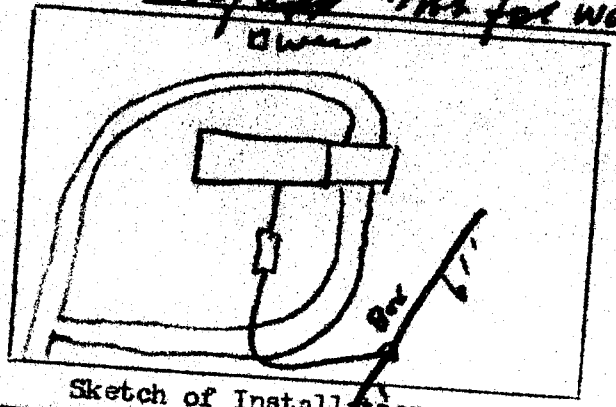

Sketch of Installation

R.A.L.

Sanitarian