Pool added 7/2011. *THIS PERMIT REPLACES PREVIOUS PERMIT ISSUED ON 09/28/2004. (I)

IREDELL COUNTY HEALTH DEPARTMENT

STATESVILLE 704-878-5305 MOORESVILLE 704-664-5281

IMPROVEMENT PERMIT / AUTHORIZATION TO CONSTRUCT / OPERATION PERMIT / EXISTING SYSTEM INSPECTION

PERMIT# 137425 PIN# 4764-45-6952 DATE 08/24/06

OWNER OR APPLICANT R+L CONSTRUCTORS, LLC PHONE: Business 704-880-8219 Home 704-881-0071

ADDRESS 120 WHITE DOGWOOD LN. STATESVILLE, NC 28625

LOCATION HWY 64 E. (R) BELL FARM RD. (R) SKYLAND DR., (R) CARTER FARM DR., (R) CAPSTONE CT., LOT ON RIGHT,

SUBDIVISION CARTER FARM BLOCK / SECTION I LOT 2 LOT AREA 0.782 Ac. SITE CLASS Ps DESIGN FLOW 360 GPD L.T.A.R. 0.24 GPD/Ft²

Septic Tank: 1,000 Gallons; STB 1012 Date 10-3-06

Pump Tank: 1,000 Gallons; PT 17 Date 10-26-06

Pump Make: Gould Model WE0312H1 Serial No.

Nitrification Field: No Fields 1 Square Feet EQ to 1500 Linear Feet 380

No Lines 4@95' Trench Width 36" Max Trench Bottom Depth 36" Gravel Depth N/A ☐ Gravity ☒ Pressure ☐ Slab ☒ Crawl Space ☐ Basement w/plumbing ☐ Basement wo/plumbing

☒ New System ☐ Repair ☐ Expansion System Type: I II (III) IV V VI

System Description: 25% Reduc., Pump

Repair System Description: 50% Reduc., Pump, L.P.

Maintenance Agreement Required: ☐ Yes ☒ No

☒ House/Mod. Home ☐ Mobile Home ☐ Business ☐ Other

No. Bedrooms 3 No. Persons ___ No. Employees ___


Water Supply: ☐ Individual ☒ Public ☐ Community

Comments:/Conditions:


Comments:/Conditions:

Yellow Septic Tank Riser Extensions

INITIAL SITE SKETCH *SCALE: ~1"=50'

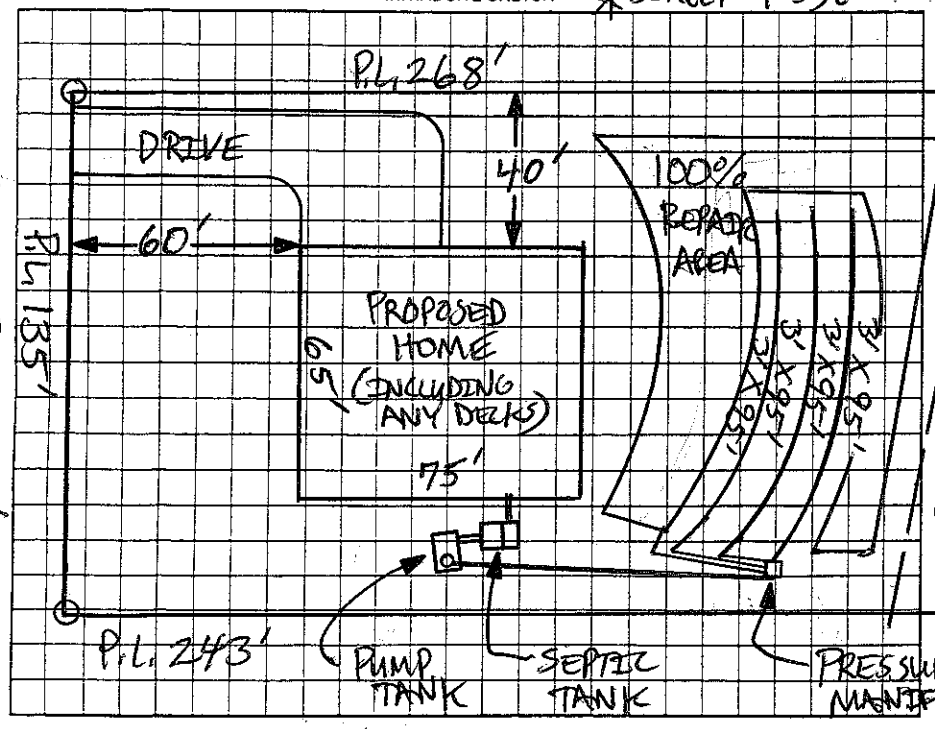

AS BUILT SKETCH

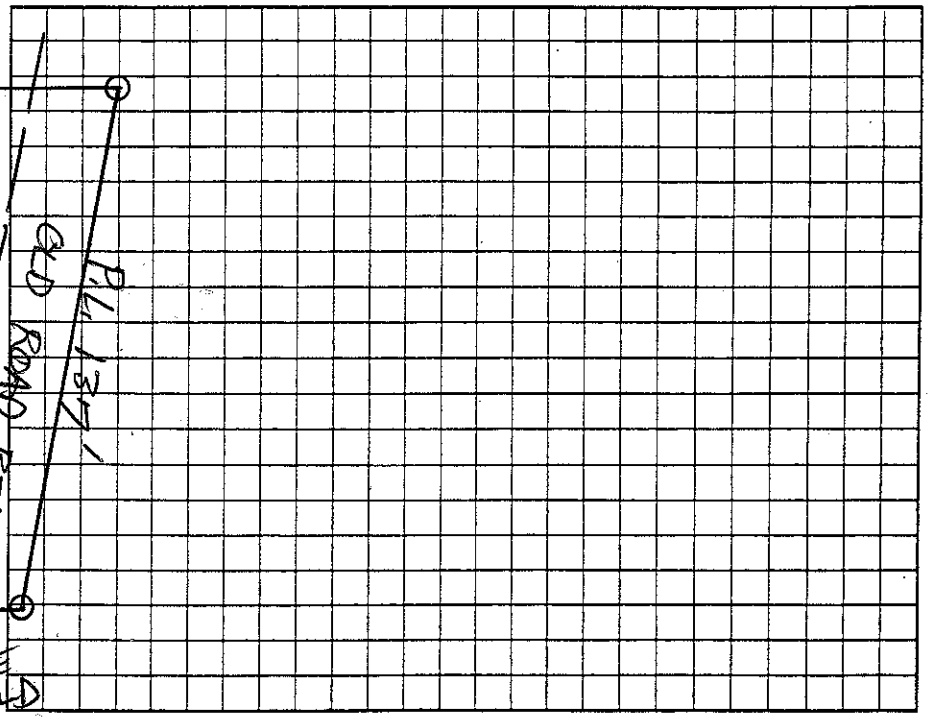

Permit can be suspended or revoked if any false information is supplied toward securing the permit/any unauthorized changes are made to the site/any unauthorized changes are made in the installation of the system. Improvement Permit with plat valid without expiration ☐ Improvement Permit with site plan valid for sixty months ☒ Authorization to Construct is valid for a period equal to that of Improvement Permit – not to exceed sixty months.

Signed: Tony Wil date 8/25/06 Installed by: Steve Jordan

Improvement Permit by: Patrick Mitchell date 08/24/06 Operation Permit by: James Allen date 4-19-07

Authorization to Construct by: Patrick Mitchell date 08/24/06 Existing System Inspection by: ___ date ___

HEALTH DEPT. COPY: WHITE OWNER COPY (FINAL): YELLOW OWNER COPY (INITIAL): PINK