IREDELL COUNTY HEALTH DEPARTMENT

STATESVILLE 704-878-5305 MOORESVILLE 704-664-5281

IMPROVEMENT PERMIT / AUTHORIZATION TO CONSTRUCT / OPERATION PERMIT / EXISTING SYSTEM INSPECTION

PERMIT# 133480 PIN# 4764468181 DATE 2-8-06

OWNER OR CONTRACTOR Pickens Corp. PHONE: Business 704 878 9837 Home

ADDRESS 166 Skyland Dr.

LOCATION Hwy 64 East (R) Bell Farm (R) Skyland Dr.

SUBDIVISION Skyland BLOCK / SECTION LOT 12 LOT AREA .682 SITE CLASS PS DESIGN FLOW 360 L.T.A.R. .25

Septic Tank: 1000 Gallons; STB 3/2 Date 11/22/03
Pump Tank: Gallons; PT Date
Pump Make: Model Serial No.
Nitrification Field: No Fields 1 Square Feet 1440 Linear Feet 360
No Lines 4 Trench Width 3 Max Trench Bottom Depth 30" Gravel Depth n/a

☒ New System ☐ Repair System Type: I II III IV V VI
System Description: 25% Reduction - Gravity
Repair System Description: 25% Reduction - Pump
Maintenance Agreement Required: ☐ Yes ☐ No

☒ House/Mod. Home ☐ Mobile Home ☐ Business ☐ Other
No. Bedrooms No. Bathrooms No. Employees

☐ Slab ☒ Crawl Space ☐ Basement w/plumbing ☐ Basement wo/plumbing


Water Supply: ☐ Individual ☒ Public ☐ Community

Comments:/Conditions:


Comments:/Conditions:

* USED POLY-LOK FITTER IN S.T.

INITIAL SITE SKETCH

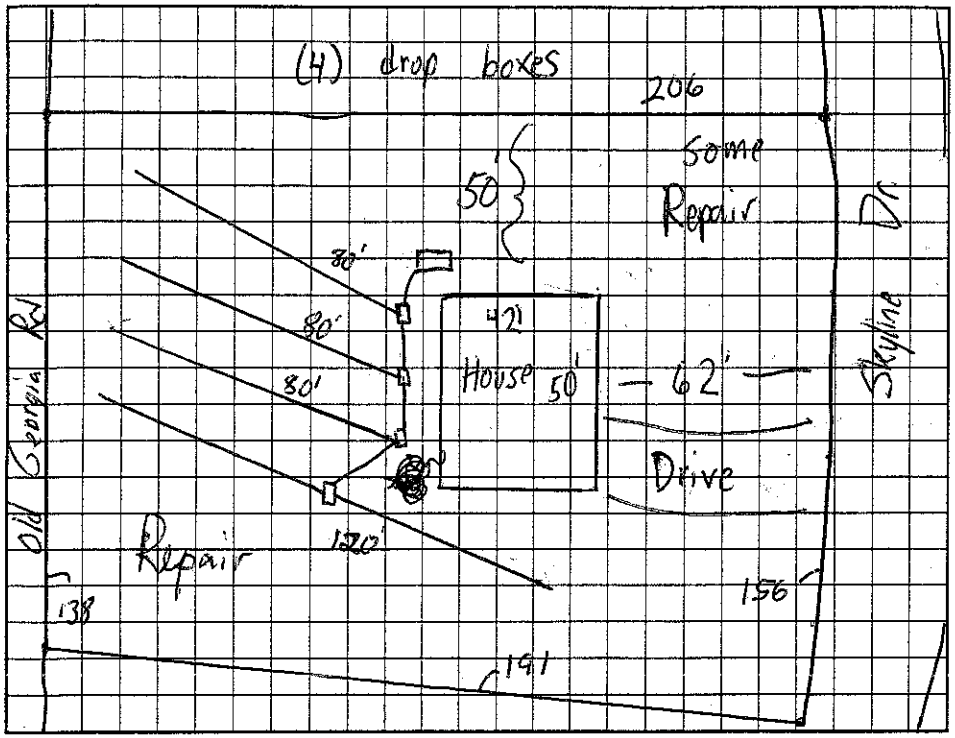

AS BUILT SKETCH

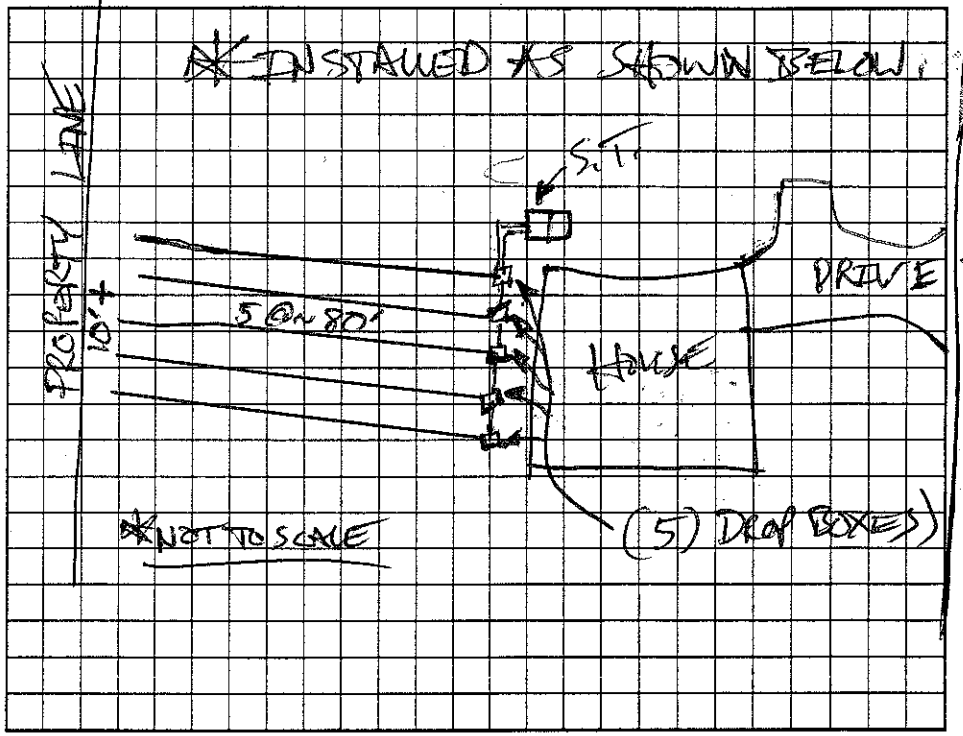

Permit can be suspended or revoked if any false information is supplied toward securing the permit/any unauthorized changes are made to the site/any unauthorized changes are made in the installation of the system. Improvement Permit with plat valid without expiration. Improvement Permit with site plan valid for sixty months. Authorization to Construct is valid for a period equal to that of Improvement Permit – not to exceed sixty months.

Signed: Gene Pickens date 2-2-06 Installed by: WES LYTTON

Improvement Permit by: James Dunn date 2-8-06 Operation Permit by: [illegible] date 08/25/06

Authorization to Construct by: James Dunn date 2-8-06 Existing System Inspection by: date

HEALTH DEPT. COPY: WHITE OWNER COPY (FINAL): YELLOW OWNER COPY (INITIAL): PINK