IREDELL COUNTY HEALTH DEPARTMENT

Statesville Office (704) 878-5305 Mooresville Office (704) 660-3625 PERMIT # 178946

IMPROVEMENT PERMIT / AUTHORIZATION TO CONSTRUCT / OPERATION PERMIT / EXISTING SYSTEM

PIN # 4764494673

APPLICANT: Sheri K Munday APPLICANT ADDRESS: 279 Bell Farm Rd

SITE ADDRESS: 279 Bell Farm Rd PHONE: 704-408-8394 ALT. PHONE:

SITE DIRECTIONS: I40E to HWY 64, (R) on Bell Farm Rd House on (R)

SUBDIVISION: n/a SECTION: n/a LOT # n/a LOT AREA: .981 DESIGN FLOW: Ex L.T.A.R.: Ex

Septic Tank	Ex.	(gal)	STB		Date						
Pump Tank		(gal)	PT		Date						
Pump Make			Model		Serial #						
# Nitrification Fields	1	# Lines	2	Linear Ft:	~200 Ft.						
Trench Width	Ex.	Max. Trench Bottom Depth	Ex	Gravel Depth	Ex						

☐ New System ☐ Repair ☐ Expansion System Type: I (II) III IV V VI

System Description: TCT - gravity

Repair System Description:

Maintenance Agreement Required: ☐ YES ☒ NO

☒ GRAVITY ☐ PRESSURE

☒ Residence No. Bedrooms 2

☐ Business No. Persons

☐ Other No. Employees

☐ Slab ☒ Crawl Space

☐ Basement w/plumbing ☐ Basement w/o plumbing


Water Supply: ☒ Private ☐ Public ☐ Community

Comments / Conditions:

System installed in 1956. No permit found

INITIAL SITE SKETCH

AS BUILT SKETCH

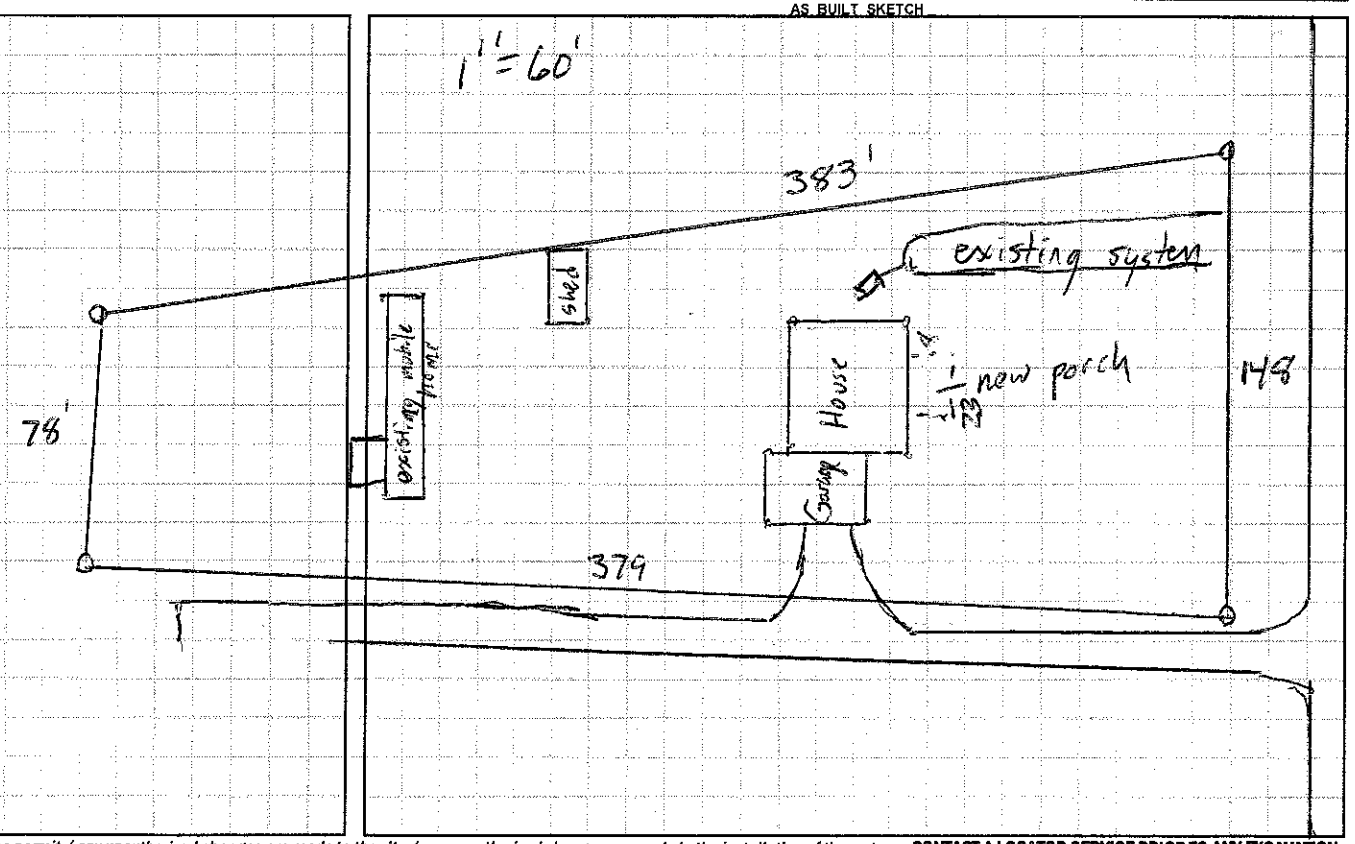

Permit can be suspended or revoked if any false information is supplied toward securing the permit / any unauthorized changes are made to the site / any unauthorized changes are made in the installation of the system. **CONTACT A LOCATOR SERVICE PRIOR TO ANY EXCAVATION**

☐ **IMPROVEMENT PERMIT** *with plat valid without expiration.* ☐ **IMPROVEMENT PERMIT** *with site plan valid for 60 mos.* ☐ **AUTHORIZATION TO CONSTRUCT** *valid for period equal to IMPROVEMENT PERMIT--not to exceed 60 mo.*

Owner / Applicant Signature: Robert C. Munday Date: 5-29-13 Installed by:

IMPROVEMENT PERMIT by: Date: OPERATION PERMIT by: Date:

AUTHORIZATION TO CONSTRUCT by: Date: Existing System Inspected by: Date: 5-29-13

Health Dept. Copy - WHITE Applicant (Final Approval) - YELLOW Applicant (Conditional Approval) - PINK