IREDELL COUNTY HEALTH DEPARTMENT

STATESVILLE 704-878-5305 MOORESVILLE 704-664-5281

IMPROVEMENT PERMIT / AUTHORIZATION TO CONSTRUCT / OPERATION PERMIT / EXISTING SYSTEM INSPECTION

PERMIT# 89346 PIN# 4764491817 PT DATE 5/25/00

OWNER OR CONTRACTOR RODNEY LITTLE PHONE: Business 878-2307 Home

ADDRESS 274 BELL FARM RD. STATESVILLE NC 28625

LOCATION 870 E - TR BELL FARM - ON (LT.) #274

SUBDIVISION — BLOCK / SECTION — LOT — LOT AREA 1.53Ac SITE CLASS PS DESIGN FLOW 360 gal L.T.A.R. .3 gal/ft =

Septic Tank: 1000 Gallons; STB 1012 Date 7-17-00
Pump Tank: Gallons; PT Date
Pump Make: Model Serial No.
Nitrification Field: No Fields 1 Square Feet 1200 Linear Feet 400
No Lines 4@100' Trench Width 36" Max Trench Bottom Depth 36"

☒ New System ☐ Repair System Type: I II III IV V VI
System Description: GRAVITY CONVENTIONAL
Repair System Description: SAME
Maintenance Agreement Required: ☐ Yes ☒ No
Gravel Depth 12" ☐ Slab ☒ Crawl Space ☐ Basement w/plumbing ☐ Basement wo/plumbing


☒ House/Mod. Home No. Bedrooms 3
☐ Mobile Home No. Bathrooms 3
☐ Business No. Employees
☐ Other

Water Supply: ☒ Individual ☒ Public ☐ Community

Comments:/Conditions:

Comments:/Conditions: SEPTIC TANK WITH RISERS INSTALLED USING "POLYLOK" FILTER

INITIAL SITE SKETCH

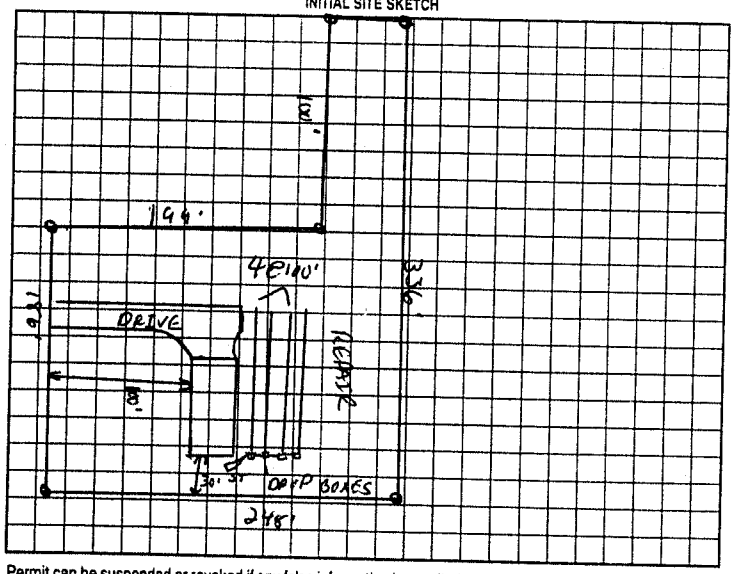

AS BUILT SKETCH

SYSTEM INSTALLED ACCORDING TO INITAL SITE SKETCH

Permit can be suspended or revoked if any false information is supplied toward securing the permit/any unauthorized changes are made to the site/any unauthorized changes are made in the installation of the system. Improvement Permit with plat valid without expiration. Improvement Permit with site plan valid for sixty months. Authorization to Construct is valid for a period equal to that of Improvement Permit – not to exceed sixty months.

~~Signed~~ Rodney Little date 5-26-00
Improvement Permit by: C. Hyatt KS date 5/25/00
Authorization to Construct by: C. Hyatt KS date 5/25/00

Installed by: DAVID YOUNTZ
Operation Permit by: STEVE HENDRICK date 9-18-00
Existing System Inspection by: date

HEALTH DEPT. COPY: WHITE OWNER COPY (FINAL): YELLOW OWNER COPY (INITIAL): PINK