IREDELL COUNTY HEALTH DEPARTMENT

STATESVILLE 704-878-5305 MOORESVILLE 704-664-5281

IMPROVEMENT PERMIT / AUTHORIZATION TO CONSTRUCT / OPERATION PERMIT / EXISTING SYSTEM INSPECTION

PERMIT# REPAIR PIN# 4764-51-5373 DATE 6-5-04

OWNER OR CONTRACTOR THOMAS E. LEE, SR PHONE: Business Home 704-871-0360

ADDRESS 146 KAYWOOD DR, STATESVILLE, NC 28625-9104

LOCATION US 64 EAST, TR BELL FARM RD, TR BELLWOOD, TR KAYWOOD DRIVE, 2ND HOUSE ON RIGHT

SUBDIVISION BELLWOOD BLOCK / SECTION LOT 39 LOT AREA 1.42 ACRES SITE CLASS. PS DESIGN FLOW 600 L.T.A.R. EXISTING (0.15 GPD/FT²)

Septic Tank: EXISTING Gallons; STB Date

Pump Tank: Gallons; PT Date

Pump Make: Model Serial No.

Nitrification Field: No Fields 1 Square Feet 480 Linear Feet 160

No Lines TWO Trench Width 36" Max Trench Bottom Depth ~36"

☐ New System ☑ Repair System Type: I, II, III, IV, V, VI

System Description:

Repair System Description: CONVENTIONAL, GRAVITY

Maintenance Agreement Required: ☐ Yes ☑ No

Gravel Depth 24" ☐ Slab ☐ Crawl Space ☑ Basement w/plumbing ☐ Basement wo/plumbing

☑ House/Mod. Home No. Bedrooms 5

☐ Mobile Home No. Bathrooms 3

☐ Business No. Employees


☐ Other

Water Supply: ☑ Individual ☐ Public ☐ Community WELL


Comments:/Conditions: ① INSTALL TWO NEW DRAWLINES AS FLAGGED USING 24" STONE ② THIS PERMIT SERVES AS "NOTICE OF VIOLATION," SYSTEM TO BE REPAIRED BY 7-5-04

Comments:/Conditions: SYSTEM REPAIRED AS SHOWN BELOW USING INFILTRATOR CHAMBERS INSTEAD OF STONE WITH PRIOR HEALTH DEPT. APPROVAL

INITIAL SITE SKETCH ~ SCALE: 1" = 40'

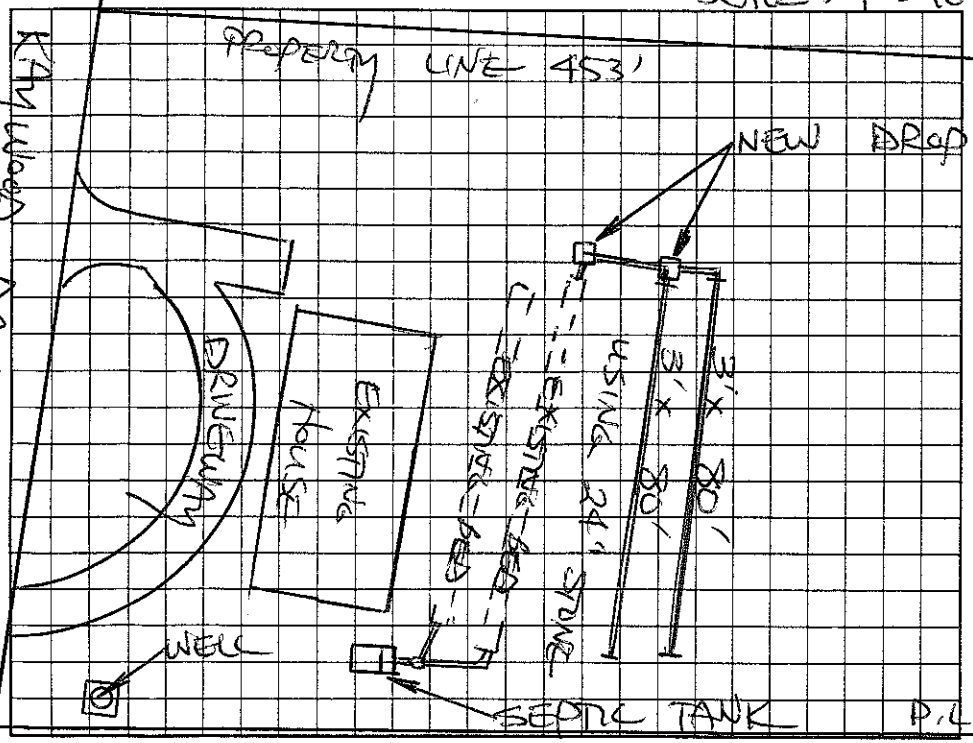

AS BUILT SKETCH

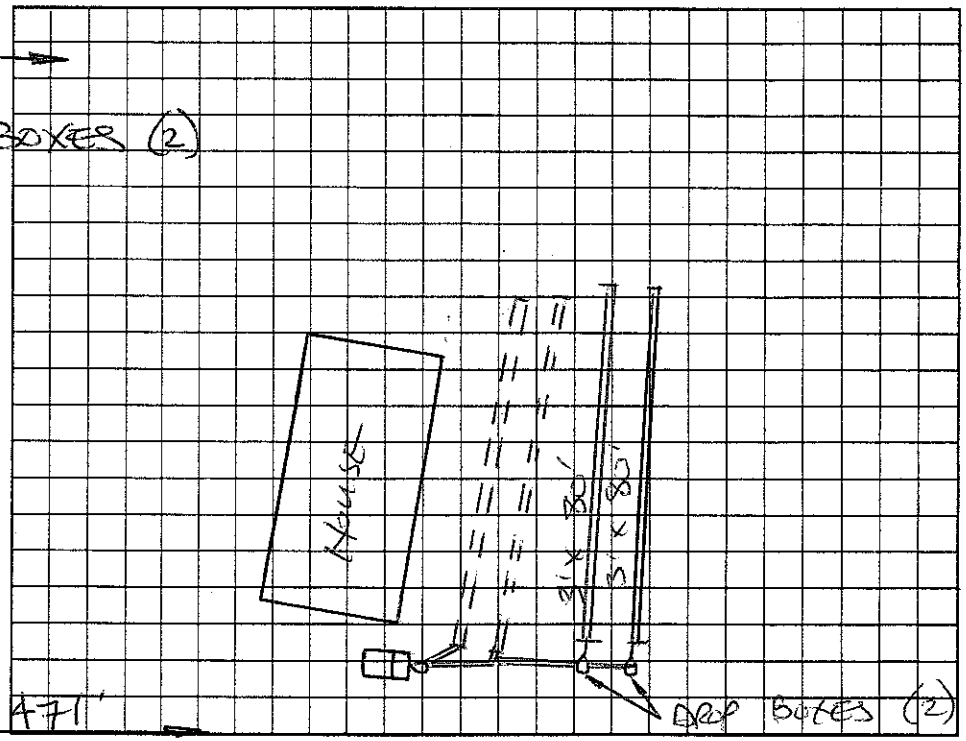

Permit can be suspended or revoked if any false information is supplied toward securing the permit/any unauthorized changes are made to the site/any unauthorized changes are made in the installation of the system. Improvement Permit with plat valid without expiration. Improvement Permit with site plan valid for sixty months. Authorization to Construct is valid for a period equal to that of Improvement Permit – not to exceed sixty months.

Signed: Thomas E Lee Sr date 6-5-04 Installed by: A-1 BACKHOE

Improvement Permit by: STEVE HEDRICK date 6-5-04 Operation Permit by: STEVE HEDRICK date 8-9-04

Authorization to Construct by: STEVE HEDRICK date 6-5-04 Existing System Inspection by: date

HEALTH DEPT. COPY: WHITE OWNER COPY (FINAL): YELLOW OWNER COPY (INITIAL): PINK