IREDELL COUNTY HEALTH DEPARTMENT - *ENVIRONMENTAL HEALTH* ☑ STATESVILLE OFFICE 704-878-5305 ☐ MOORESVILLE OFFICE 704-664-5281

IMPROVEMENT PERMIT / AUTHORIZATION TO CONSTRUCT(a) OPERATION PERMIT(a) / EXISTING SYSTEM INSPECTION

PERMIT # 169 655 / Repair PIN # 4764-60-3127 DATE 22 December 2011

OWNER Dora Ramirez APPLICANT: PHONE: Home/Cell # (704) 929-8019 Business #

SITE ADDRESS 790 Bell Farm Rd. SRL OWNER / APPLICANT ADDRESS

SITE DIRECTIONS Hwy 64 E TR Bell Farm Rd Cross Creek - ON Rt.


SUBDIVISION BLOCK / SECTION LOT # LOT AREA 1.15 Ac± DESIGN FLOW 360 gpd L.T.A.R. 0.3 / 1.2

Septic Tank	Exist.	Gallons: STB		Date	☐ New System	☑ Repair	☐ Expansion System	Type I II (III) IV V VI	☑ Residence	No. Bedrooms 3	Water Supply
Pump Tank		Gallons: P T		Date	System Description:				☐ Business	No. Persons	☐ Private
Pump Make		Model		Serial #	Repair System Description:	25% Reduction			☐ Other	No. Employees	☐ Public
No. Nitrification Fields:	1	No. Lines	3	Linear Feet 800	Maintenance Agreement Required	☐ YES	☑ NO		☐ Slab	☑ Crawl Space	☐ Community
Trench Width	36"	Max. Trench Bottom Depth	36"	Gravel Depth NA	☑ GRAVITY	☐ PRESSURE			☐ Basement w/plumbing	☐ Basement w/o plumbing	


Comments / Conditions Cut-off old lines / Add tee to ST / Keep 5' off any buildg foundation. / Keep 15' from other septic syst serving mobile home. / Install filter tee.

* Keep 50' from well.

INITIAL SITE SKETCH

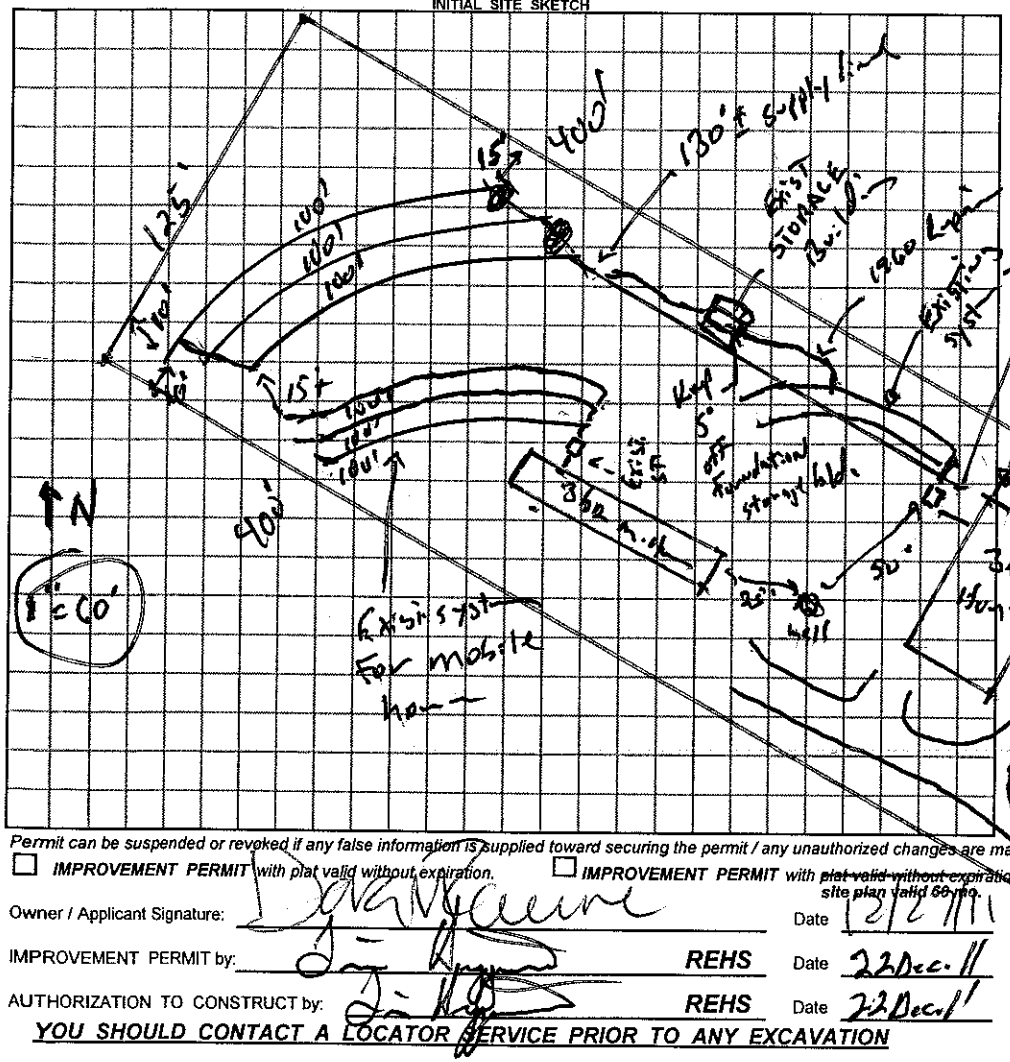

AS BUILT SKETCH

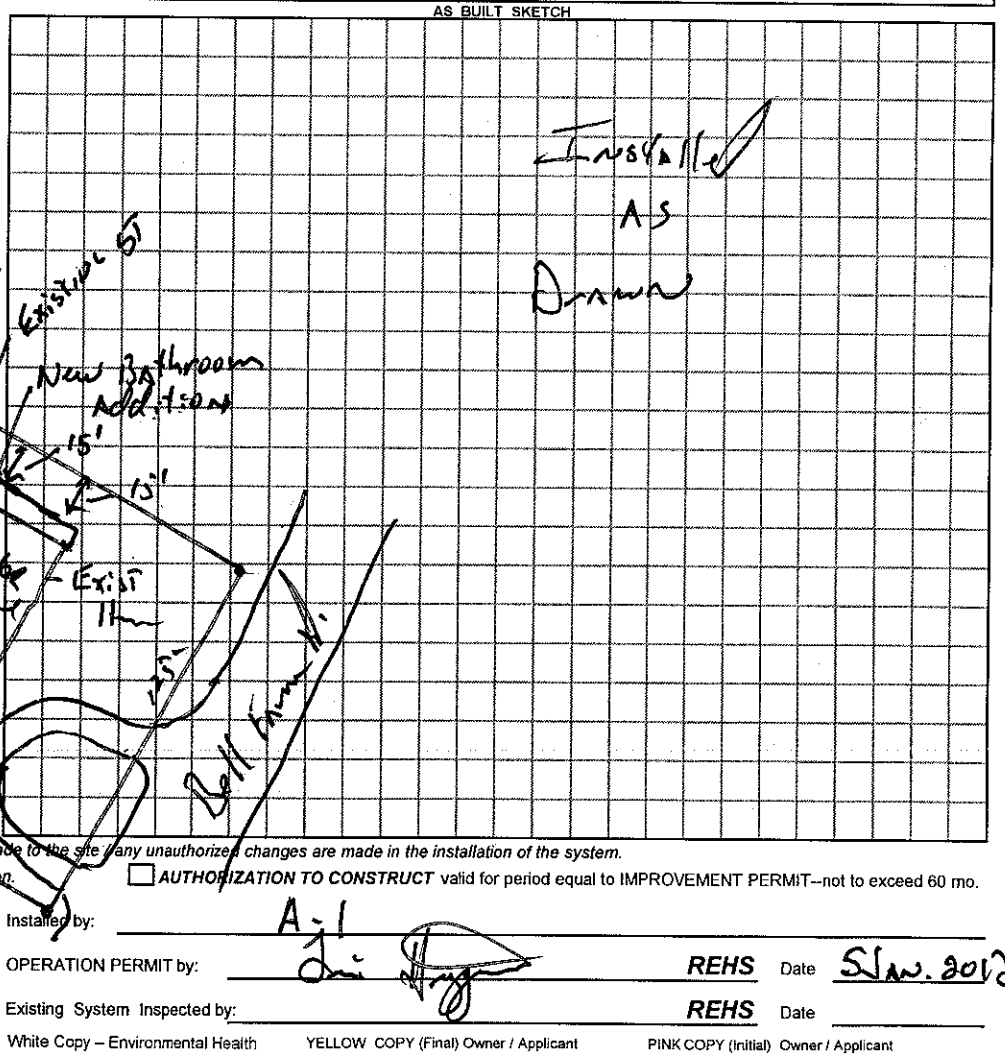

Permit can be suspended or revoked if any false information is supplied toward securing the permit / any unauthorized changes are made to the site / any unauthorized changes are made in the installation of the system.

☐ ***IMPROVEMENT PERMIT*** with plat valid without expiration. ☐ ***IMPROVEMENT PERMIT*** with ~~plat valid without expiration~~ site plan valid 60 mo. ☐ ***AUTHORIZATION TO CONSTRUCT*** valid for period equal to IMPROVEMENT PERMIT--not to exceed 60 mo.

Owner / Applicant Signature: Dora Ramirez Date 12/22/11 Installed by: A-1

IMPROVEMENT PERMIT by: REHS Date 22 Dec. 11

AUTHORIZATION TO CONSTRUCT by: REHS Date 22 Dec. 11

OPERATION PERMIT by: REHS Date 5 Jan. 2012

Existing System Inspected by: REHS Date

YOU SHOULD CONTACT A LOCATOR SERVICE PRIOR TO ANY EXCAVATION

White Copy – Environmental Health YELLOW COPY (Final) Owner / Applicant PINK COPY (Initial) Owner / Applicant