IREDELL COUNTY HEALTH DEPARTMENT

Statesville Phone TR 3-7271 — Mooresville Phone NO 3-1271

PERMIT TO INSTALL SEPTIC TANK

Permit NO. _____ Permit Date 5 - 6 - 19 6 a

Owner Don Gaither Address Bell Rd

Installed By C Hoke Address 121


Location of Property frame hs on left before creek on Bell Rd. off Atwayside · 1/2 mile.

Tank		Capacity		Length of Lines		Fixtures	
Block	( )	800	( )	150'	( )	No. of Baths	( )
Precast	( )	900	( )	175'	( )	Dishwasher	( )
		1000	( )	200'	( )	Garbage Grdr.	( )
		1100	( )	225'	( )	Auto-Washer	( )
		1200	( )	250'	( )	Other	
		Other		Other			

NOTIFY HEALTH DEPARTMENT AT LEAST EIGHT HOURS BEFORE TANK IS TO BE INSPECTED.

Final Inspection _____ 19 6a Approved ( ) Disapproved ( )

Remarks Repair - 100' - tight soil · Well sat

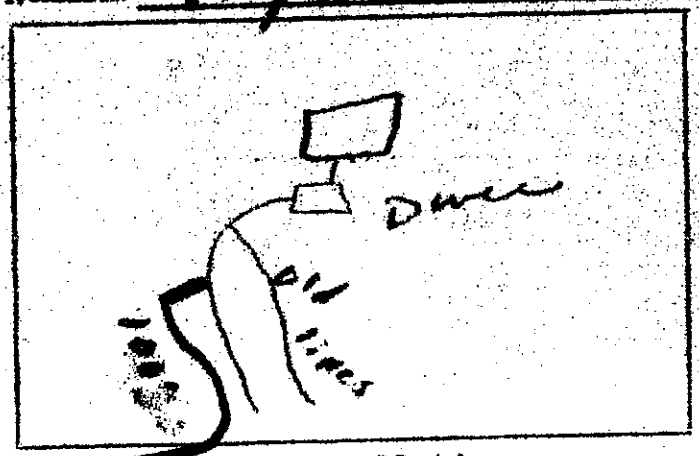

Sketch of Installation

P.A.J.

Sanitarian