IREDELL COUNTY HEALTH DEPARTMENT

Statesville Phone TR 3-7271 Mooresville Phone NO 3-1271

PERMIT TO INSTALL SEPTIC TANK

Permit NO._____ Permit Date 5-6 19 6

Owner Dwight Baker (CLYDE HOKE) Address Bell Rd

Installed By C Noke Address RT -


Location of Property left on Wayside on Bear rd. before Creek on left - Brick - 1½ miles

Tank		Capacity		Length of Lines		Fixtures	
Block	( )	800	( )	150'	( )	No. of Baths	( )
Precast	( )	900	( )	175'	( )	Dishwasher	( )
		1000	( )	200'	( )	Garbage Grdr.	( )
		1100	( )	225'	( )	Auto-Washer	( )
		1200	( )	250'	( )	Other	
		Other		Other			

NOTIFY HEALTH DEPARTMENT AT LEAST EIGHT HOURS BEFORE TANK IS TO BE INSPECTED.

Final Inspection _____ 19__ Approved ( ) Disapproved ( )

Remarks Septic - 100 ft. - tile soil - well 6 - 1

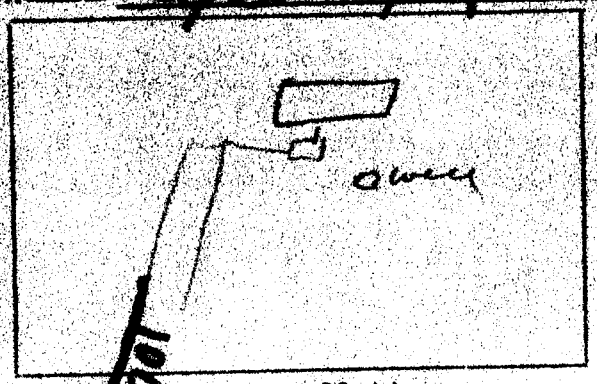

Sketch of Installation

P.A.I

Sanitarian