IREDELL COUNTY HEALTH DEPARTMENT

STATESVILLE 704-878-5305 MOORESVILLE 704-664-5281

IMPROVEMENT PERMIT / CERTIFICATE OF COMPLETION / OPERATION PERMIT / EXISTING SYSTEM INSPECTION

PROPERTY DESCRIPTION NO. _____ DATE 7/19/93 TAX MAP NO. 5M-4-A-52/53

OWNER OR CONTRACTOR MICHAEL HARRISON PHONE: Business _____ Home _____

ADDRESS 104 KATIE LANE

LOCATION 45 TO E TL BELL FARM RD, TL BELLWOOD TR KATIE LN. (#) ON (R)

SUBDIVISION BELLWOOD BLOCK / SECTION _____ LOT 52/53 LOT AREA _____ SITE CLASS. _____ L.T.A.R. 0.3 GPD

Water Supply: ☑ Individual ☐ Community ☐ Public WELL

Septic Tank: EXISTING Gallons; STB _____ Date _____

Pump Tank: _____ Gallons; PT _____ Date _____

Nitrification Field: No Fields 2 Square Feet 155 Linear Feet 517

No Lines 4 Trench Width 36" Trench Depth 36" Gravel Depth 12"

☐ New System ☑ Repair System Type: I. II. III. IV. V. VI

System Description: _____

Repair System Description: CONV. GRAVITY

Maintenance Agreement Required: ☐ Yes ☑ No

☑ House/Mod. Home No. Bedrooms _____ Garbage Disposal: ☐ Yes ☑ No

☐ Mobile Home No. Bathrooms _____ Auto. Dishwasher: ☐ Yes ☐ No


☐ Business No. Employees _____ Auto. Washing Machine: ☐ Yes ☐ No

☐ Other _____ Other _____


☐ Slab ☐ Crawl Space ☐ Basement w/plumbing ☐ Basement wo/plumbing

Comments ① BULL RUN VALVE INSTALLED AS SHOWN #1 TO NEW LINES #2 TO EXISTING - SWITCH VALVE AT 6 MONTH INTERVALS, MINIMUM ② NEW SANITARY TEE INSTALLED IN S.T. ③ S.T. PUMPED OUT 5/15/93

INITIAL SITE SKETCH

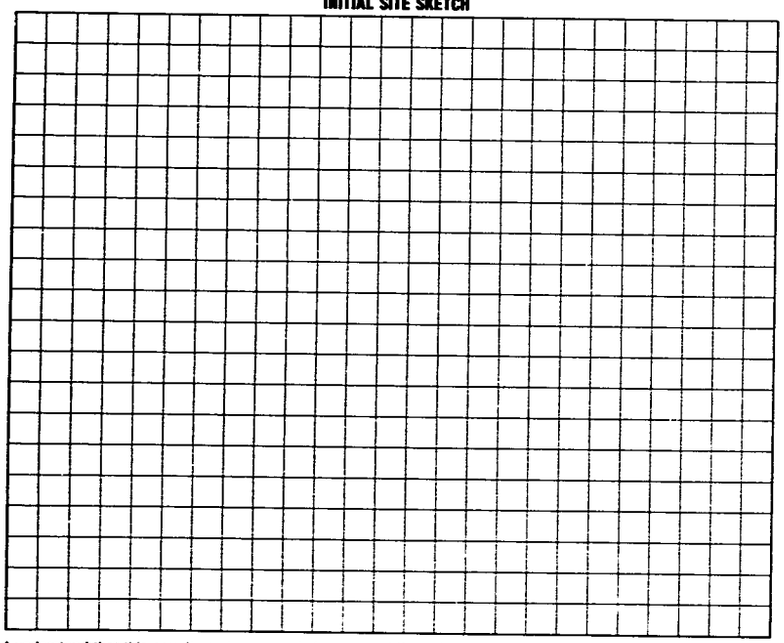

AS BUILT SKETCH

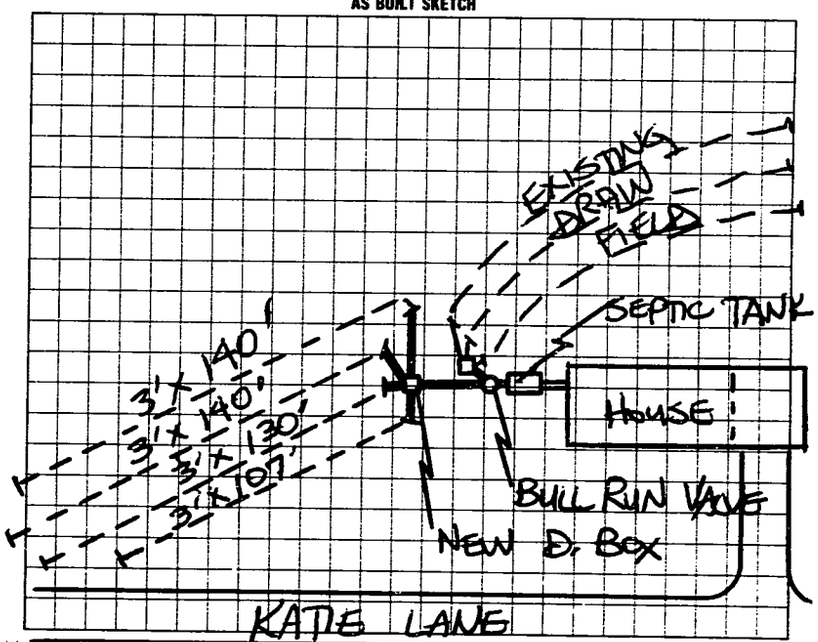

I understand that this permit can be suspended or revoked if any false information is supplied toward securing the permit/any unauthorized changes are made to the site/any unauthorized changes are made in the installation of the system. Improvement Permit is valid for 60 months from date of issuance.

Signed: _____

Improvement Permit by: J.C. MOORE date 4/7/93

Existing System Inspection by: _____ date _____

Installed by: KENNY PEARSON

Certificate of Completion by: STEVE HEARIC / MIKE DENNIS 7/19/93

Operation Permit by: _____ date _____

HEALTH DEPT. COPY: WHITE INSPECTION COPY (FINAL): GREEN OWNER COPY (FINAL): YELLOW INSPECTION COPY (INITIAL): PINK OWNER COPY (INITIAL): GOLD