IREDELL COUNTY HEALTH DEPARTMENT

STATESVILLE 704-878-5305 MOORESVILLE 704-664-5281

~~IMPROVEMENT PERMIT~~ / AUTHORIZATION TO CONSTRUCT / OPERATION PERMIT / EXISTING SYSTEM INSPECTION

PERMIT# 107487 PIN# 4764-64-2375 4764-64-2355 / 4764/64/5054 DATE 07-26-02

OWNER OR CONTRACTOR Steven & Robin Porter PHONE: Business _____ Home 871-0549 / 880-5479

ADDRESS P.O. BOX 135 / RT 97 BOX 135 BRENTON, WV 24818

LOCATION 64 E, (R) BELL FARM, (R) FARMWOOD LOT 2/3 ON LEFT

SUBDIVISION MAYWOOD BLOCK / SECTION _____ LOTS 2/3 (2+) LOT AREA 2.0 AC + 1/3 AC SITE CLASS PS SEWER DISCHARGE DESIGN FLOW 450 L.T.A.R. .26

Septic Tank: 1000 Gallons; STB 714 Date 4-21-00

Pump Tank: 1000 Gallons; PT 283 Date 2-25-03

Pump Make: GOULDS Model WE10J2H Serial No. 1PWE1012H

Nitrification Field: No Fields 1 Square Feet 600 Linear Feet 300'

No Lines 4 Trench Width 24" Max Trench Bottom Depth 36" Gravel Depth N/A

☒ New System ☐ Repair System Type: I. II. III (IV.) V. VI

System Description: LP PANEL

Repair System Description: LP PANEL

Maintenance Agreement Required: ☒ Yes ☐ No

☒ House/Mod. Home No. Bedrooms 4

☐ Mobile Home No. Bathrooms 3

☐ Business No. Employees ____

☐ Other ____


☐ Slab ☒ Crawl Space ☐ Basement w/plumbing ☐ Basement wo/plumbing

Water Supply: ☐ Individual ☒ Public ☐ Community


Comments/Conditions: (1) SYSTEM HAS NOT CHANGED. HOUSE HAS BEEN CENTERED ON LOT LINE BETWEEN LOTS 2 & 3 AS DRAWN BELOW (1) USED PROGRAM SPECIALIST

Comments/Conditions: PREVIOUS WORK (PUMP SIZING, SOILS, SYSTEM DESIGN) & PERFORMED A LIMITED RELAYOUT BY JUST MOVING THE HOUSE SITE. (3) CALL BY INSTALLATION FOR CONSULTATIVE VISIT. (4) SEE ATTACHED FOR SYSTEM DESCRIPTION & DESIGN

INITIAL SITE SKETCH

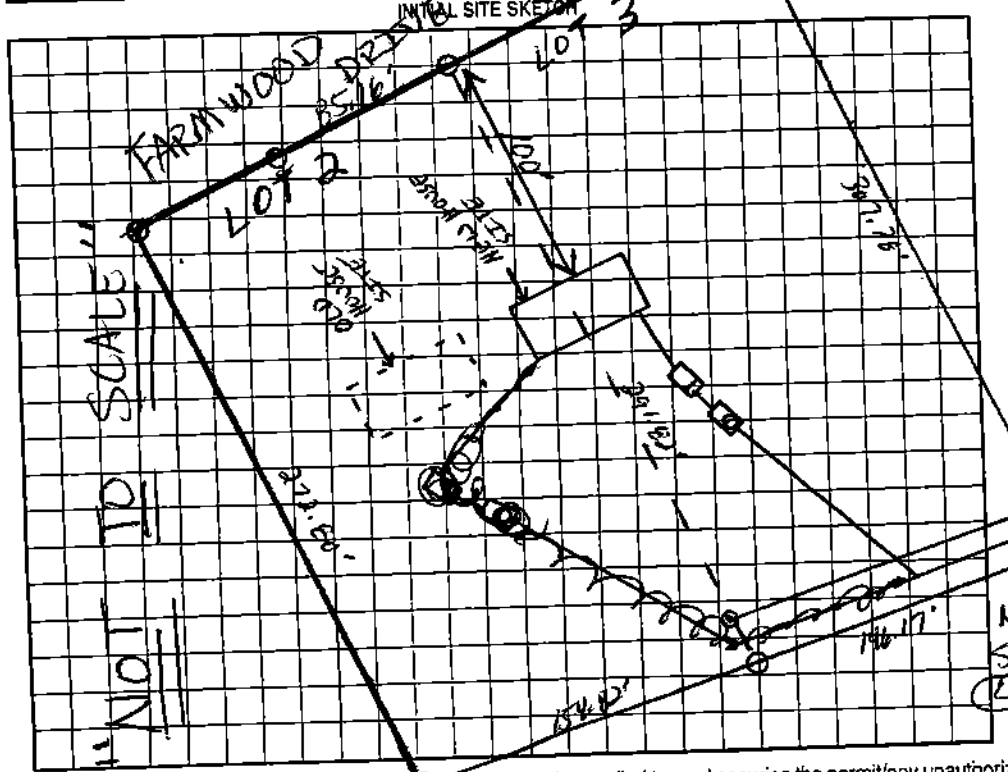

AS BUILT SKETCH

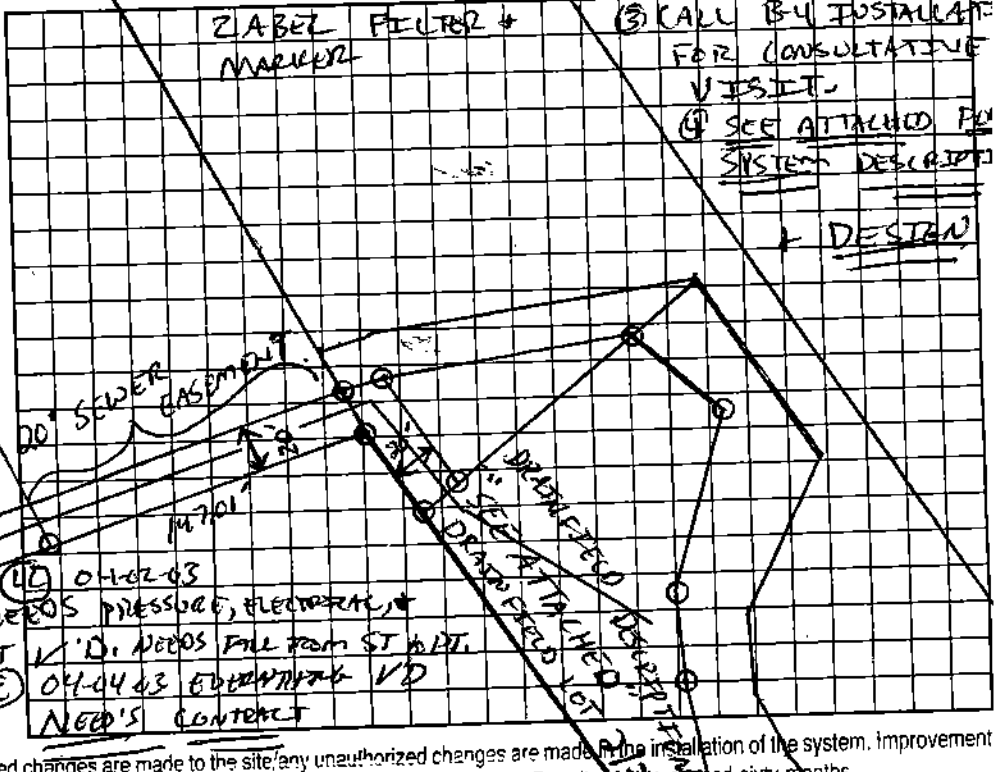

Permit can be suspended or revoked if any false information is supplied toward securing the permit/any unauthorized changes are made to the site/any unauthorized changes are made in the installation of the system. Improvement Permit with plat valid without expiration. Improvement Permit with site plan valid for sixty months. Authorization to Construct is valid for a period equal to that of Improvement Permit – not to exceed sixty months

Signed: Robin S Porter date 7-26-02 Installed by: MARTY TUCKER

Improvement Permit By: [signature] date 07-26-02 Operation Permit by: [signature] RS date 4-8-03

Authorization to Construct by: [signature] date 07-26-02 Existing System Inspection by: _____ date _____

WHITE COPY (FINAL) YELLOW ____ OWNER COPY (INITIAL): PINK