**IREDELL COUNTY HEALTH DEPARTMENT - *ENVIRONMENTAL HEALTH*** ☐ STATESVILLE OFFICE 704-878-5305 ☐ MOORESVILLE OFFICE 704-664-5281

**IMPROVEMENT PERMIT / AUTHORIZATION TO CONSTRUCT / OPERATION PERMIT / EXISTING SYSTEM INSPECTION**

PERMIT # REPAIR PIN # 4764-64.9614 DATE MARCH 2, 2012

OWNER GRENDA ROM CRESWELL APPLICANT: JEFF ROM PHONE: Home/Cell # 704-902-9602 Business #

SITE ADDRESS 126 FARMWOOD DRIVE OWNER / APPLICANT ADDRESS 126 FARMWOOD DR, STATESVILLE, NC

SITE DIRECTIONS US 64 EAST, TR SELL FARM ROAD, TR FARMWOOD DRIVE, 2ND HOUSE ON RIGHT

SUBDIVISION BLOCK / SECTION LOT # LOT AREA 2.0 AC DESIGN FLOW 360 L.T.A.R. EXISTING

Septic Tank 1000 Gallons: STB 760 Date 4-14-11 ☐ New System ☑ Repair ☐ Expansion System Type I (II) III IV V VI ☑ Residence No. Bedrooms 3 Water Supply

Pump Tank Gallons: P T Date ☐ Business No. Persons ☐ Private

Pump Make Model Serial # System Description: CONVENTIONAL, GRAVITY ☐ Other No. Employees ☑ Public


No. Nitrification Fields: 1 No. Lines EX Linear Feet EX Repair System Description: CONVENTIONAL, GRAVITY ☐ Slab ☑ Crawl Space ☐ Community

Trench Width EX Max. Trench Bottom Depth EX Gravel Depth EX Maintenance Agreement Required ☐ YES ☐ NO ☐ Basement w/plumbing ☐ Basement w/o plumbing

☑ GRAVITY ☐ PRESSURE

Comments / Conditions REPLACE EXISTING SEPTIC TANK AS SHOWN, MINIMUM 5' FROM BUILDING FOUNDATION

INITIAL SITE SKETCH

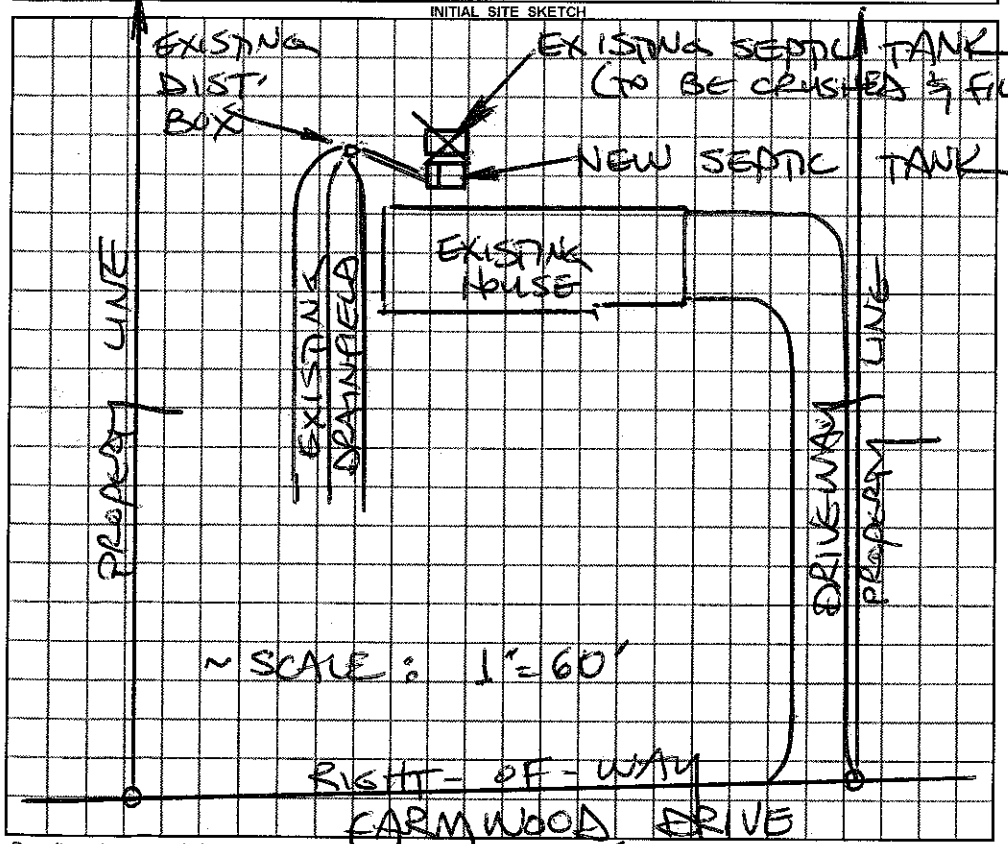


AS BUILT SKETCH

*Permit can be suspended or revoked if any false information is supplied toward securing the permit / any unauthorized changes are made to the site / any unauthorized changes are made in the installation of the system.*

☐ *IMPROVEMENT PERMIT* with plat valid without expiration. ☑ *IMPROVEMENT PERMIT* with plat valid without expiration. site plan valid 60 mo. ☑ *AUTHORIZATION TO CONSTRUCT* valid for period equal to IMPROVEMENT PERMIT--not to exceed 60 mo.

Owner / Applicant Signature: Date 3-5-12 Installed by: Leitz Septic

IMPROVEMENT PERMIT by: STEVE HENDRICK REHS Date 3-2-2012 OPERATION PERMIT by: REHS Date 3-6-12

AUTHORIZATION TO CONSTRUCT by: STEVE HENDRICK REHS Date 3-2-2012 Existing System Inspected by: REHS Date

***YOU SHOULD CONTACT A LOCATOR SERVICE PRIOR TO ANY EXCAVATION***

White Copy – Environmental Health YELLOW COPY (Final) Owner / Applicant PINK COPY (Initial) Owner / Applicant