57368

IREDELL COUNTY HEALTH DEPARTMENT

STATESVILLE 704-878-5305 MOORESVILLE 704-664-5281

IMPROVEMENT PERMIT / CERTIFICATE OF COMPLETION / OPERATION PERMIT / EXISTING SYSTEM INSPECTION

PROPERTY DESCRIPTION NO. 22007 DATE 8-30-95 TAX MAP NO. 55-A-140 Watershed: ☐ Yes ☒ No

OWNER OR CONTRACTOR Larry Horne PHONE: Business _____ Home 528-0848

ADDRESS _____

LOCATION 64E TR Bell Rd TL Dogwood Est.

SUBDIVISION Dogwood Est BLOCK / SECTION _____ LOT 15 LOT AREA _____ SITE CLASS _____ DESIGN FLOW 360 L.T.A.R. _____

Septic Tank: _____ Gallons; STB _____ Date _____
Pump Tank: _____ Gallons; PT _____ Date _____
Pump Make: _____ Model _____ Serial No. _____
Nitrification Field: No Fields ____ Square Feet _____ Linear Feet _____
No Lines _____ Trench Width _____ Max Trench Bottom Depth _____ Gravel Depth _____

☐ New System ☐ Repair System Type: I, II, III, IV, V, VI
System Description: _____
Repair System Description: _____
Maintenance Agreement Required: ☐ Yes ☐ No

☐ House/Mod. Home No. Bedrooms 3
☐ Mobile Home No. Bathrooms 1
☐ Business No. Employees ____
☐ Other _____
☐ Slab ☐ Crawl Space ☐ Basement w/plumbing ☐ Basement wo/plumbing


Water Supply:
☐ Individual
☐ Community
☒ Public

Comments:

Comments:

INITIAL SITE SKETCH

AS BUILT SKETCH

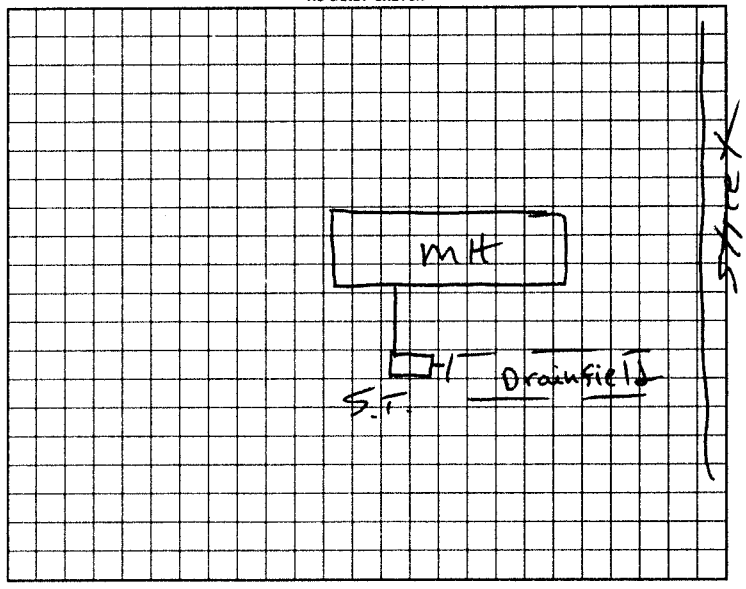

I understand that this permit can be suspended or revoked if any false information is supplied toward securing the permit/any unauthorized changes are made to the site/any unauthorized changes are made in the installation of the system.

Signed: _____ Installed by: _____

Improvement Permit by: _____ date _____ Certificate of Completion by: _____ date _____

Existing System Inspection by: P.C. Moore date 8-30-95 Operation Permit by: _____ date _____

HEALTH DEPT. COPY: WHITE INSPECTION COPY (FINAL): GREEN OWNER COPY (FINAL): YELLOW INSPECTION COPY (INITIAL): PINK OWNER COPY (INITIAL): GOLD