IREDELL COUNTY HEALTH DEPARTMENT

STATESVILLE 704-878-5305 MOORESVILLE 704-664-5281

IMPROVEMENT PERMIT / AUTHORIZATION TO CONSTRUCT / OPERATION PERMIT / EXISTING SYSTEM INSPECTION

PERMIT# _____ PIN# _____ DATE 1-13-00

OWNER OR CONTRACTOR Bill Bowser PHONE: Business 873-0054 Home _____

ADDRESS Bell Fm Road Statesville, N.C.

LOCATION 70E to Bell Fm Rd TR Dogwood Est. Follow to end

SUBDIVISION Dogwood Est BLOCK / SECTION _____ LOT 15 LOT AREA _____ SITE CLASS. _____ DESIGN FLOW 240 L.T.A.R. .13

Septic Tank: Ex. Gallons: STB _____ Date _____

Pump Tank: _____ Gallons: PT _____ Date _____

Pump Make: _____ Model _____ Serial No. _____

Nitrification Field: No Fields 1 Square Feet 600 Linear Feet 200

No Lines 2 Trench Width 72" Max Trench Bottom Depth 36" Gravel Depth 18"

☐ New System ☑ Repair System Type: I and III, IV, V, VI

System Description: _____

Repair System Description: Conv. Gravity

Maintenance Agreement Required: ☐ Yes ☑ No

☐ House/Mod. Home ☑ Mobile Home ☐ Business ☐ Other


No. Bedrooms 2 No. Bathrooms 2 No. Employees _____

☐ Slab ☐ Crawl Space ☐ Basement w/plumbing ☐ Basement w/o plumbing

Water Supply: ☐ Individual ☑ Public ☐ Community

Comments:/Conditions:

INITIAL SITE SKETCH

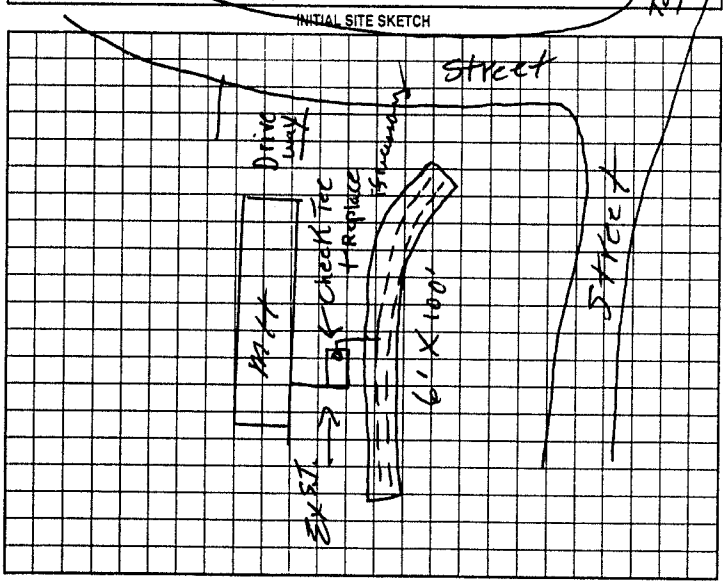

Comments:/Conditions:

AS BUILT SKETCH

Same as initial Sketch

Permit can be suspended or revoked if any false information is supplied toward securing the permit/any unauthorized changes are made to the site/any unauthorized changes are made in the installation of the system. Improvement Permit with plat valid without expiration. Improvement Permit with site plan valid for sixty months. Authorization to Construct is valid for a period equal to that of Improvement Permit – not to exceed sixty months.

Signed: Julie L. Matthews date _____ Installed by: Esker Elter

Improvement Permit by: P. C. Moore date 1-13-00 Operation Permit by: P. C. Moore date 2-17-00

Authorization to Construct by: P. C. Moore date 1-13-00 Existing System Inspection by: _____ date _____

HEALTH DEPT. COPY: WHITE OWNER COPY (FINAL): YELLOW OWNER COPY (INITIAL): PINK