IREDELL COUNTY HEALTH DEPARTMENT

Statesville Phone TR 3-7271 Mooresville Phone NO 3-1271

PERMIT TO INSTALL SEPTIC TANK

Permit No. _____ Permit Date July 10 1969

Owner Jack Sigmon Trailer Park Address Statesville, N.C.

Installed By Owner Address Statesville, N.C.


Location of Property Y.U.R

Tank		Capacity		Length of Lines		Fixtures	
Block	( )	1000	(✓)	225'	(✓)	No. of Baths	( )
Precast	(✓)	1250	( )	250'	( )	Dishwasher	( )
		1500	( )	Other _____		Garbage Grdr.	( )
		Other _____				Other _____	

NOTIFY HEALTH DEPARTMENT AT LEAST EIGHT HOURS BEFORE TANK IS TO BE INSPECTED.

Final Inspection July 10 1969 Approved (✓) Disapproved ( )

Remarks _____

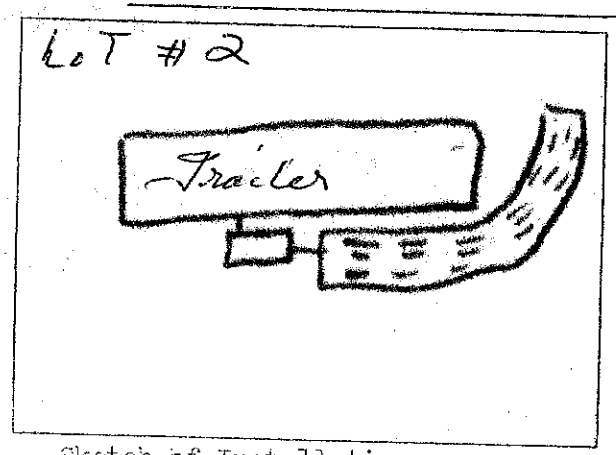

Sketch of Installation

Kathleen W. Johnson R.S.

Sanitarian