IREDELL COUNTY HEALTH DEPARTMENT

STATESVILLE 704-878-5305 MOORESVILLE 704-664-5281

IMPROVEMENT PERMIT / CERTIFICATE OF COMPLETION / OPERATION PERMIT / EXISTING SYSTEM INSPECTION

PROPERTY DESCRIPTION NO. 22832 DATE 12-7-95 TAX MAP NO. 55-A-140 Watershed: ☐ Yes ☒ No

OWNER OR CONTRACTOR David Fyock PHONE: Business — Home —

ADDRESS 11701 McCord Rd. Huntersville, N.C. 28078

LOCATION Hwy 70E TL Bell Farm Rd. TR Dogwood Estates. Bare R at tee, 4th lot on L

SUBDIVISION Dogwood Estates BLOCK / SECTION — LOT 29 LOT AREA — SITE CLASS: Existing DESIGN FLOW 360 L.T.A.R. Existing

Septic Tank: ____ Gallons; STB ____ Date ____

Pump Tank: Existing Gallons; PT ____ Date ____

Pump Make: ____ Model System Serial No. Inspection

Nitrification Field: No Fields ____ Square Feet ____ Linear Feet ____

No Lines ____ Trench Width ____ Max Trench Bottom Depth ____ Gravel Depth ____

☐ New System ☐ Repair System Type: I, II, III, IV, V, VI

System Description: Existing System

Repair System Description: Inspection

Maintenance Agreement Required: ☐ Yes ☐ No

☐ Slab ☑ Crawl Space ☐ Basement w/plumbing ☐ Basement wo/plumbing

☐ House/Mod. Home No. Bedrooms 3

☑ Mobile Home No. Bathrooms 2

☐ Business No. Employees ____


☐ Other ____

Water Supply: ☐ Individual ☑ Community ☐ Public


Comments:

Comments: Existing Septic System shows no visible sign of malfunction at time of inspection. Lot vacant at time of inspection. Tank located, drain lines, too deep to probe. Keep MH 5' from any part of Septic System.

INITIAL SITE SKETCH

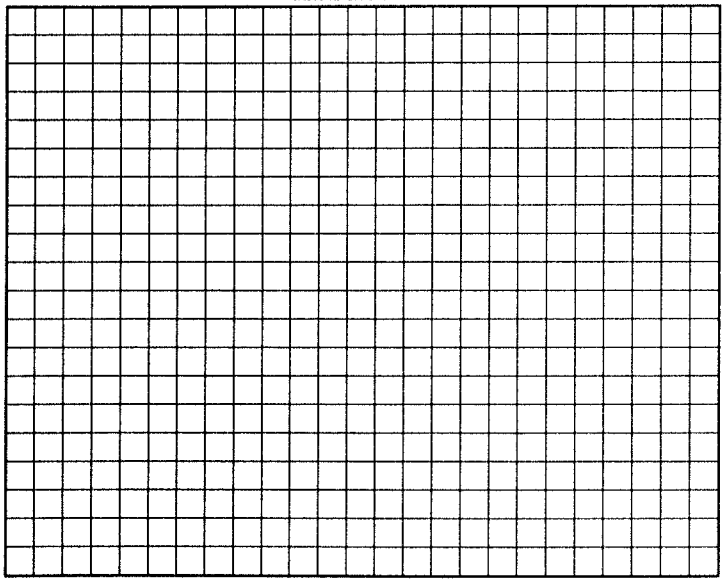

AS BUILT SKETCH

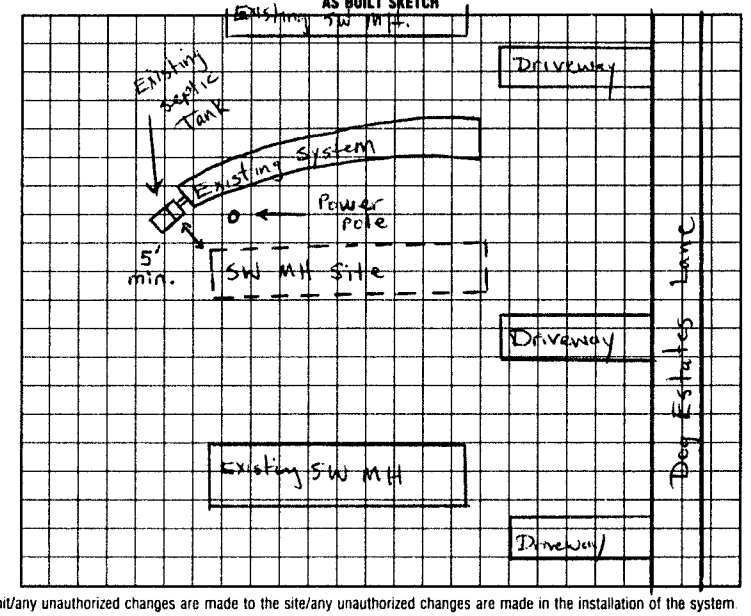

I understand that this permit can be suspended or revoked if any false information is supplied toward securing the permit/any unauthorized changes are made to the site/any unauthorized changes are made in the installation of the system.

Signed: ____ Installed by: ____

Improvement Permit by: ____ date ____ Certificate of Completion by: ____ date ____

Existing System Inspection by: Michael D Dennis date 12-6-95 Operation Permit by: ____ date ____

HEALTH DEPT. COPY: WHITE INSPECTION COPY (FINAL): GREEN OWNER COPY (FINAL): YELLOW INSPECTION COPY (INITIAL): PINK OWNER COPY (INITIAL): GOLD