IREDELL COUNTY HEALTH DEPARTMENT

STATESVILLE 704-878-5305 MOORESVILLE 704-664-5281

IMPROVEMENT PERMIT / AUTHORIZATION TO CONSTRUCT / OPERATION PERMIT / EXISTING SYSTEM INSPECTION

PERMIT# 15144 PIN# 4726474206 DATE 7-2-8

OWNER OR APPLICANT Pam Carolina Properties LLC PHONE: Business _____ Home 989-226-8410

ADDRESS 3442 Ocean View St Laguna Beach CA 92651

LOCATION 64E to Bellhaven RD Dogwood estate 90 to left 5th on right

SUBDIVISION Dogwood Estate BLOCK / SECTION _____ LOT 34 LOT AREA _____ SITE CLASS: B DESIGN FLOW 240 L.T.A.R. _____

Septic Tank: Existing Gallons: STB _____ Date _____

Pump Tank: _____ Gallons: PT _____ Date _____

Pump Make: _____ Model _____ Serial No. _____

Nitrification Field: No Fields ____ Square Feet _____ Linear Feet _____

No Lines _____ Trench Width _____ Max Trench Bottom Depth _____ Gravel Depth _____

☐ New System ☐ Repair ☐ Expansion System Type: ☐ I ☐ II ☐ III ☐ IV ☐ V ☐ VI

System Description: Existing

Repair System Description: _____

Maintenance Agreement Required: ☐ Yes ☐ No

☐ Gravity ☑ Pressure

☐ House/Mod. Home ☑ Mobile Home ☐ Business ☐ Other _____

No. Bedrooms 2 No. Persons ____ No. Employees ____

Water Supply: ☐ Individual ☑ Public ☐ Community

☐ Slab ☑ Crawl Space ☐ Basement w/plumbing ☐ Basement wo/plumbing


Comments:/Conditions:

Comments:/Conditions:

Recommended to clean tank

INITIAL SITE SKETCH

AS BUILT SKETCH

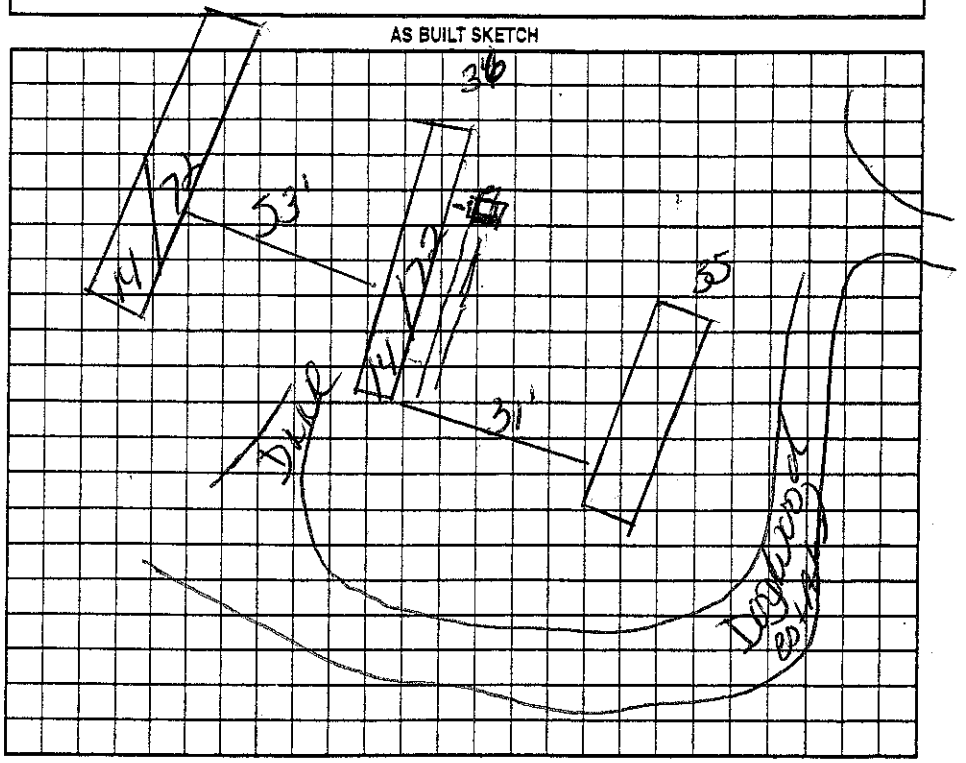

Permit can be suspended or revoked if any false information is supplied toward securing the permit/any unauthorized changes are made to the site/any unauthorized changes are made in the installation of the system. Improvement Permit with plat valid without expiration ☐ Improvement Permit with site plan valid for sixty months ☐ Authorization to Construct is valid for a period equal to that of Improvement Permit – not to exceed sixty months.

Signed: _____ date _____ Installed by: _____

Improvement Permit by: _____ date _____ Operation Permit by: _____ date _____

Authorization to Construct by: _____ date _____ Existing System Inspection by: Kenny Cook date 7-2-08

HEALTH DEPT. COPY: WHITE OWNER COPY (FINAL): YELLOW OWNER COPY (INITIAL): PINK