902-2711

IREDELL COUNTY HEALTH DEPARTMENT

STATESVILLE 704-878-5305 MOORESVILLE 704-664-5281

IMPROVEMENT PERMIT / AUTHORIZATION TO CONSTRUCT / OPERATION PERMIT / EXISTING SYSTEM INSPECTION

PERMIT# _____ PIN# 4764-5420 DATE 04-03-02

OWNER OR CONTRACTOR DOGWOOD ESTATES (WILLIAM BOWSER) PHONE: Business _____ Home _____

ADDRESS 209 E WEBSTER ST WHITEVILLE NC 28472

LOCATION HWY 64 E, (B) BELL FARM, (C) DOGWOOD CIRCLE, BEAR LEFT, ON RT AT LOT #36

SUBDIVISION DOGWOOD EST BLOCK / SECTION _____ LOT 30 LOT AREA _____ SITE CLASS _____ DESIGN FLOW 360 L.T.A.R. _____

Septic Tank: 1000 Gallons: STB 1012 Date 01-08-02
Pump Tank: _____ Gallons: PT _____ Date _____
Pump Make: _____ Model _____ Serial No _____
Nitrification Field: No Fields 1 Square Feet _____ Linear Feet 300'
No Lines 3X100' Trench Width _____ Max Trench Bottom Depth _____


☐ New System ☒ Repair System Type: I (II) III IV V VI
System Description: _____
Repair System Description: CON-I GRAV 24" STONE
Maintenance Agreement Required: ☐ Yes ☐ No

☐ House/Mod Home No Bedrooms 3
☒ Mobile Home SW No Bathrooms 2
☐ Business No Employees ____
☐ Other _____
☐ Slab ☒ Crawl Space ☐ Basement w/plumbing ☐ Basement wo/plumbing

Water Supply: ☐ Individual ☐ Public ☒ Community WELL

Comments/Conditions: (1) REDIRECT PLUMBING TO NEW SEPTIC TANK (2) MOVE SHED OFF NEW DRAINLINE AREA (3) END OF LINES NEEDS TO BE 36" DEEP + LEVEL TO BEGINNING OF LINES, -7 ie; BEGINNING OF LINES WILL BE DEEP, (4) MAKE SURE YOU SHOOT ELEVATIONS OF LINES SO ALL WILL BACK UP TO BOX. (5) INSTALLER MUST MEET WITH LORNE COOK, 704 928-2030 5-4 STARTING, (6) HAVE UTILITIES MARKED AS BUILT SKETCH (7) THIS PERMIT SERVES AS NOTICE OF VIOLATION & MUST BE REPAIRED WITHIN 30 DAYS, (8) NOTE STONE DEPTH.

INITIAL SITE SKETCH

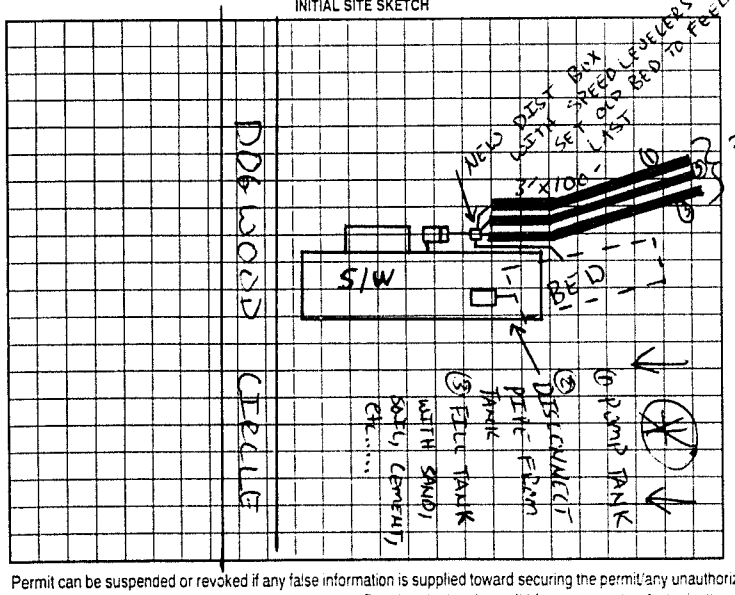

POLYLOIL FILTER & MARKER

1ST LINE = 70' 30"
2ND = 100' 24"
BED = 100' 24"
} STONE DEPTH

FEED OLD BED FROM LAST LINE BECAUSE NOT ENOUGH SPACE. LAST LINE FED LAST FOR THIS REASON.

Permit can be suspended or revoked if any false information is supplied toward securing the permit; any unauthorized changes are made to the site; any unauthorized changes are made in the installation of the system. Improvement Permit with plat valid without expiration. Improvement Permit with site plan valid for sixty months. Authorization to Construct is valid for a period equal to that of Improvement Permit – not to exceed sixty months

Signed: William H. Bowser date 4

Improvement Permit by: _____ date 04-03-02

Authorization to Construct by: _____ date 04-03-02

Installed by: STEVE JORDAN

Operation Permit by: _____ RS date 05-09-02

Existing System Inspection by: _____ date _____

HEALTH DEPT COPY WHITE OWNER COPY (FINAL) YELLOW OWNER COPY (INITIAL) PINK