IREDELL COUNTY HEALTH DEPARTMENT

STATESVILLE 704-878-5305 MOORESVILLE 704-664-5281

IMPROVEMENT PERMIT / AUTHORIZATION TO CONSTRUCT / OPERATION PERMIT / EXISTING SYSTEM INSPECTION

(C)

PERMIT# 121126 PIN# 4764-70-6199 DATE 6-16-04

OWNER OR CONTRACTOR JEFFERY TODD LLOYD PHONE: Business 704-902-3319 Home 704-873-9272

ADDRESS 757 BELL FARM ROAD, STATESVILLE NC 28625

LOCATION US 64 EAST, TR BELL FARM ROAD, TL BRAD DRIVE, AT END ON LEFT

SUBDIVISION _____ BLOCK / SECTION _____ LOT _____ LOT AREA 6.59 ACRES SITE CLASS. PS DESIGN FLOW 240 L.T.A.R. 0.25 GPD/FT²

Septic Tank: 1000 Gallons; STB 1012 Date 1-25-04

Pump Tank: _____ Gallons; PT _____ Date _____

Pump Make: _____ Model _____ Serial No. _____

Nitrification Field: No. Fields 1 Square Feet 960 Linear Feet 320

No. Lines THREE Trench Width 36" Max Trench Bottom Depth 36" Gravel Depth 12"

☑ New System ☐ Repair System Type: I (II) III. IV. V. VI

System Description: CONVENTIONAL, GRAVITY

Repair System Description: CONVENTIONAL GRAVITY

Maintenance Agreement Required: ☐ Yes ☑ No

☐ House/Mod. Home No. Bedrooms 3

☑ Mobile Home No. Bathrooms 2

☐ Business No. Employees ____

☐ Other _____


☐ Slab ☑ Crawl Space ☐ Basement w/plumbing ☐ Basement wo/plumbing

Water Supply: ☐ Individual ☑ Public ☐ Community


Comments:/Conditions: INSTALL LINES ON CONTOUR AS SHOWN

Comments:/Conditions: SEPTIC TANK WITH MARKER INSTALLED USING "TUFTITE" FILTER

INITIAL SITE SKETCH

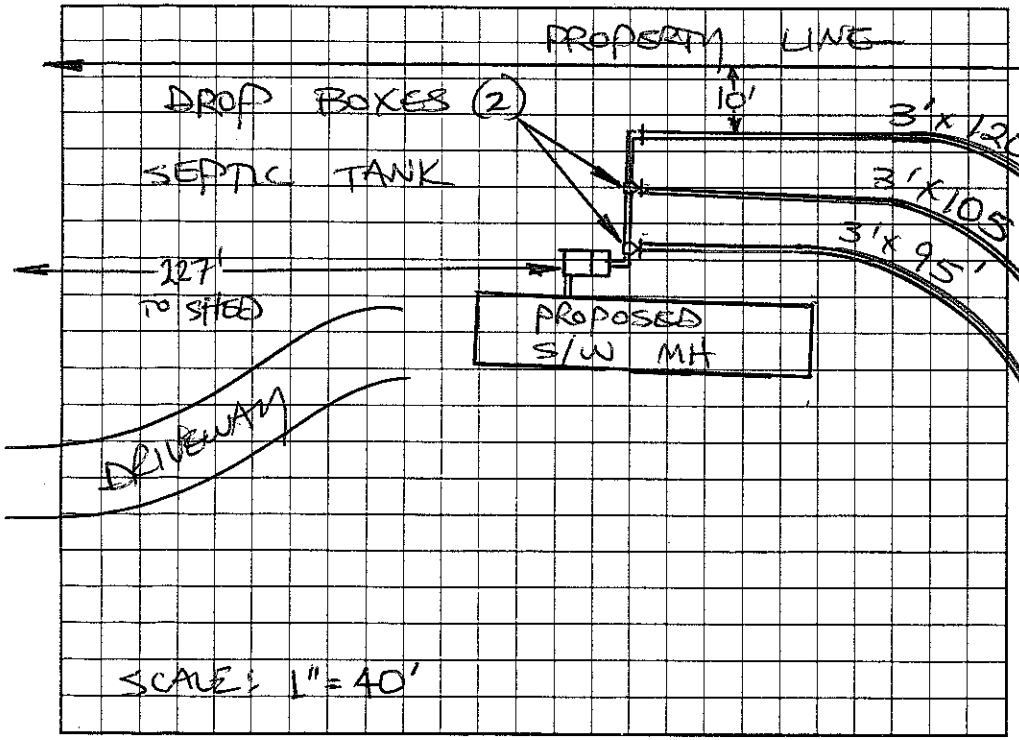

AS BUILT SKETCH

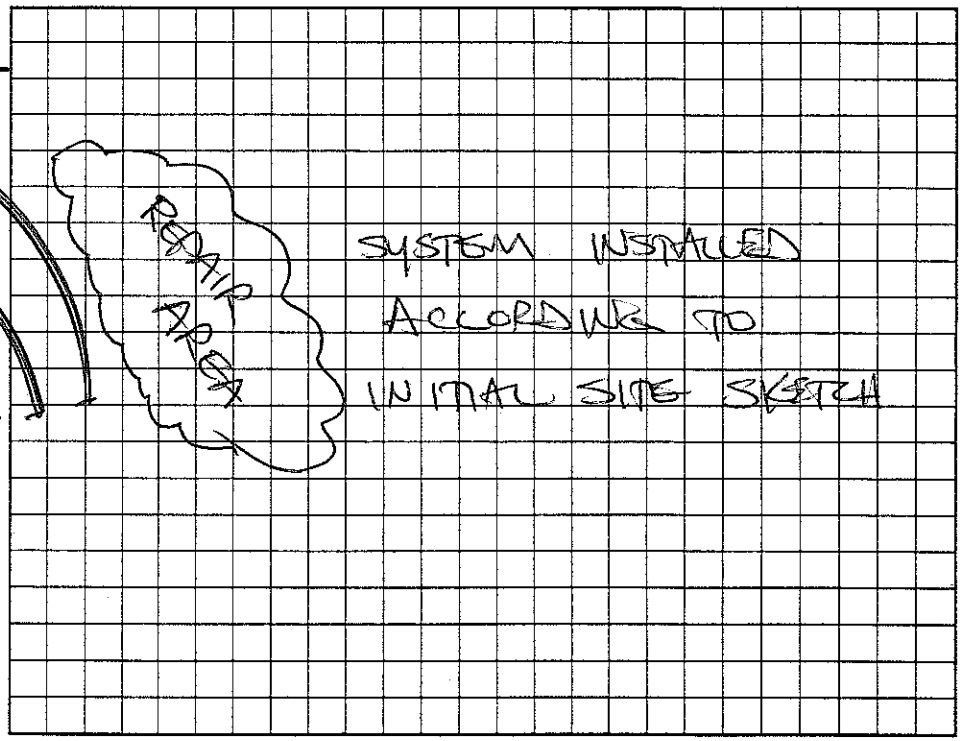

Permit can be suspended or revoked if any false information is supplied toward securing the permit/any unauthorized changes are made to the site/any unauthorized changes are made in the installation of the system. Improvement Permit with plat valid without expiration. Improvement Permit with site plan valid for sixty months. Authorization to Construct is valid for a period equal to that of Improvement Permit – not to exceed sixty months.

Signed: Mitchell O. Lloyd date 6-16-04

Improvement Permit by: STEVE HENDRICK date 6-16-04

Authorization to Construct by: STEVE HENDRICK date 6-16-04

Installed by: JEFFERY TODD LLOYD (LLOYD'S BACKHOE)

Operation Permit by: STEVE HENDRICK date 7-2-04

Existing System Inspection by: _____ date _____

HEALTH DEPT. COPY: WHITE OWNER COPY (FINAL): YELLOW OWNER COPY (INITIAL): PINK