# IREDELL COUNTY HEALTH DEPARTMENT

STATESVILLE 704-878-5305 MOORESVILLE 704-664-5281

## IMPROVEMENT PERMIT / AUTHORIZATION TO CONSTRUCT / OPERATION PERMIT / EXISTING SYSTEM INSPECTION

PERMIT# 137478 PIN# 4764-73-7259 DATE 12-8-06

OWNER OR APPLICANT J.M. WORKMAN & CO. INC PHONE: Business 704.622-3996 Home

ADDRESS 452 SOUTH MAIN ST. STE 130, DAVIDSON, NC 28036

LOCATION US 64 EAST, TR BELL FARM ROAD, ON LEFT, JUST BEFORE FOURTH CREEK.

SUBDIVISION BLOCK / SECTION LOT LOT AREA 0.801 ACRE SITE CLASS. PS DESIGN FLOW 360 L.T.A.R. 0.225 GPD/FT2

Septic Tank: 1000 Gallons; STB TP 102-100 Date 4-19-06

Pump Tank: 1000 Gallons; PT TP 117-100 Date 4-19-06

Pump Make: Model EQ. TP Serial No.

Nitrification Field: No Fields 1 Square Feet 1600 Linear Feet 400

No Lines FOUR Trench Width 36" Trench Bottom Depth 42" Gravel Depth N/A

☑ New System ☐ Repair ☐ Expansion System Type: I II (III) IV V VI

System Description: 25% REDUCTION, PUMP

Repair System Description: 25% REDUCTION, PUMP

Maintenance Agreement Required: ☐ Yes ☑ No

☐ Gravity ☑ Pressure ☐ Slab ☑ Crawl Space ☐ Basement w/plumbing ☐ Basement wo/plumbing

☑ House/Mod. Home No. Bedrooms 3

☐ Mobile Home No. Persons

☐ Business No. Employees

☐ Other

Water Supply: ☑ Individual ☐ Public ☐ Community WELL

Comments:/Conditions: ① INSTALL 25% REDUCTION SYSTEM AS SHOWN AT 42 INCHES DEEP ② INSTALL 54 INCH DEEP SUBSURFACE INTERCEPT DRAINAGE DITCH.

Comments:/Conditions: ST HAS MANUAL FLOAT INSTALLED Interceptor Ditch 54"

INITIAL SITE SKETCH

SEE ATTACHED SITE PLAN (.1948(d))
PREPARED BY ROWANS SOIL & ENVIRONMENTAL SERVICES
PROJECT #: 01-1317

AS BUILT SKETCH

Permit can be suspended or revoked if any false information is supplied toward securing the permit/any unauthorized changes are made to the site/any unauthorized changes are made in the installation of the system. Improvement Permit with plat valid without expiration ☐ Improvement Permit with site plan valid for sixty months ☑ Authorization to Construct is valid for a period equal to that of Improvement Permit – not to exceed sixty months.

Signed: date 12/11/06

Improvement Permit by: STEVE HEDRICK date 12-8-06


Authorization to Construct by: STEVE HEDRICK date 12-8-06

Installed by: A-1 Backhoe

Operation Permit by: date 2-28-06

Existing System Inspection by: date

HEALTH DEPT. COPY: WHITE OWNER COPY (FINAL): YELLOW OWNER COPY (INITIAL): PINK

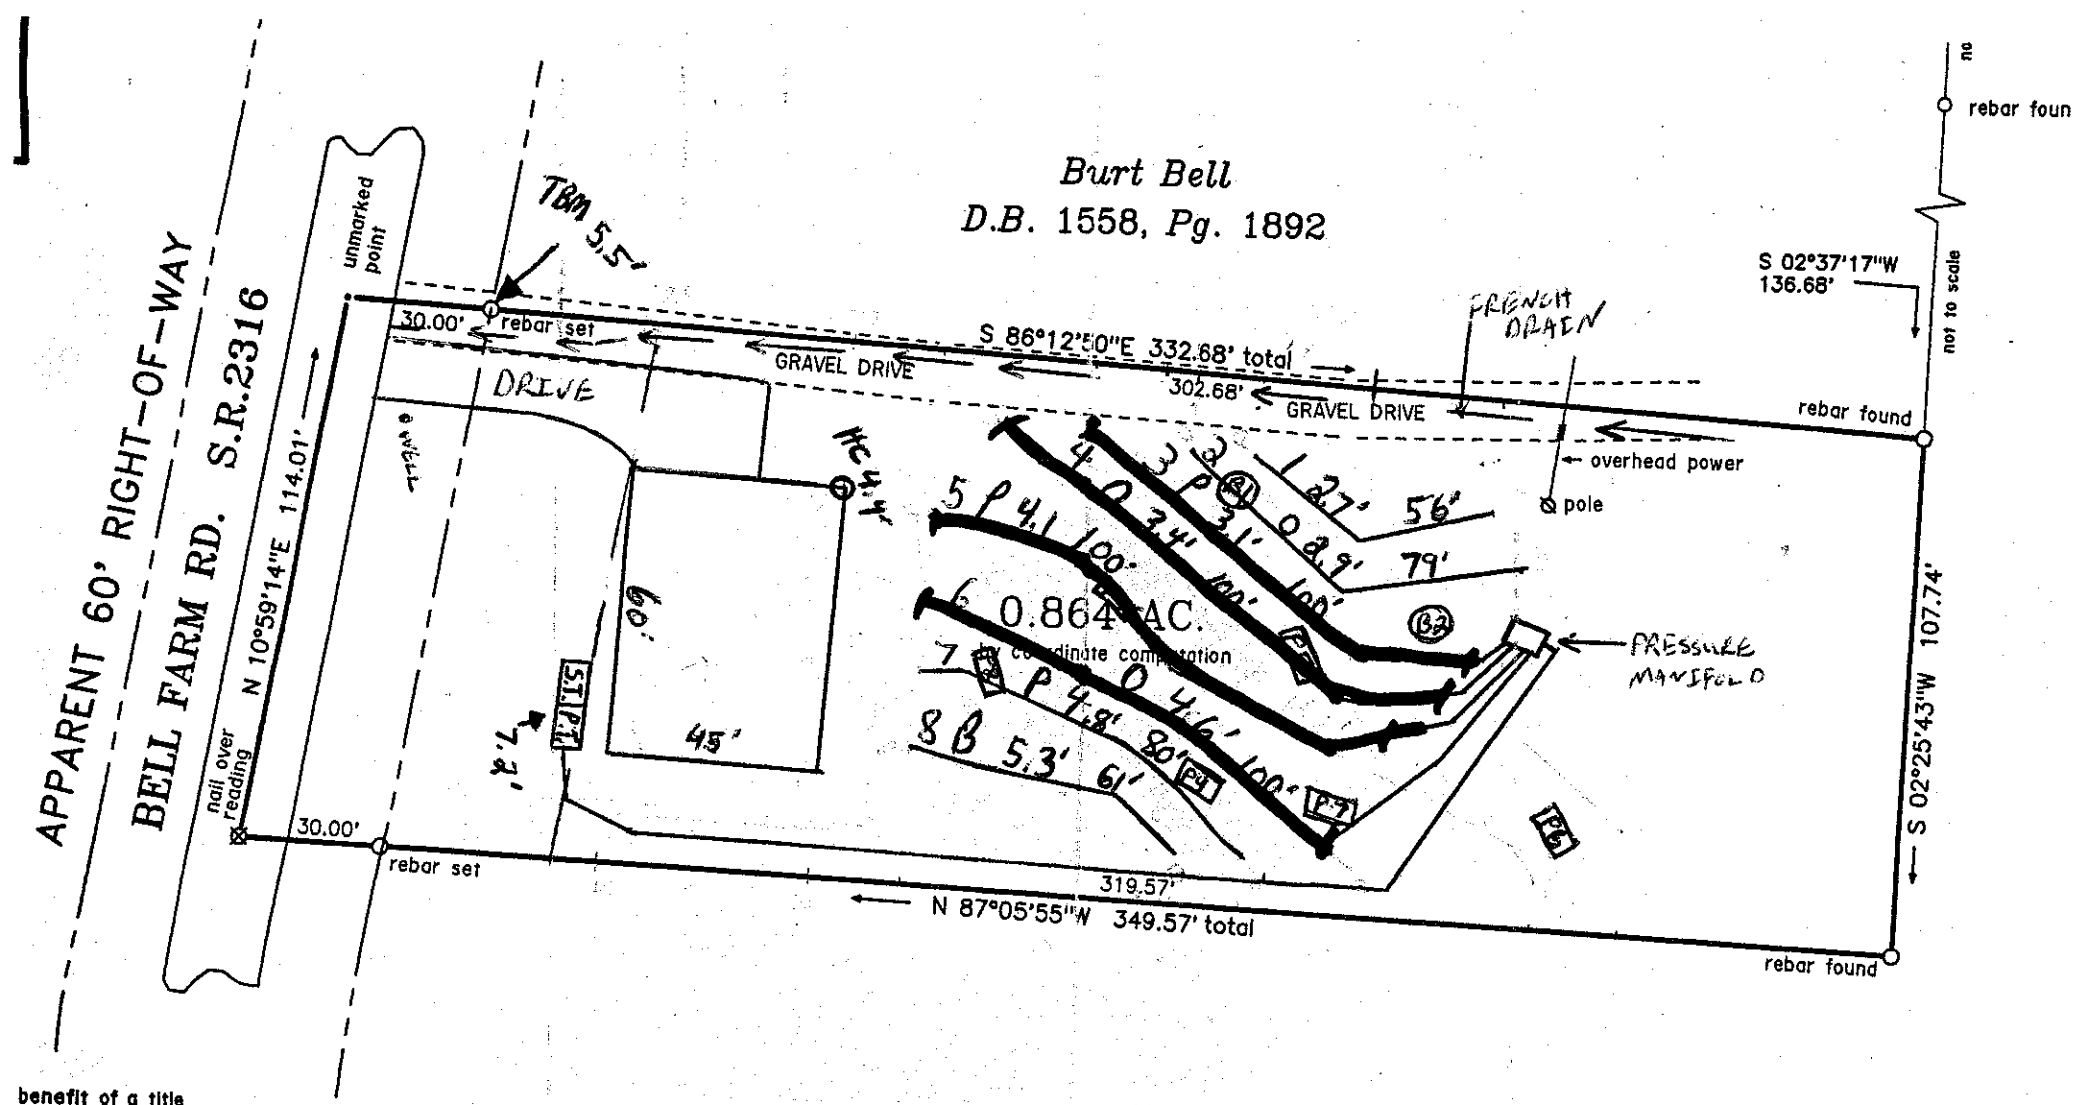


benefit of a title
discrepancies which may
ate title search.

d Surveyor, hereby certify
ervision from an actual
a precision ratio of

ober 24th, 2006.

NORTH CAROLINA PROFESSIONAL SEAL L-4414 LAND SURVEYOR W. MATTHEW JORDAN

License #4414

40 0 40 80 120
GRAPHIC SCALE – FEET

Survey

J.M. WORKMA

| Date: | 10-24-06 | Deed Reference: |
|---|---|---|
| Scale: | 1" = 40' | Tax PIN: |

Chambersburg Twsp.,

AMERICAN PLANNING & SURVEYING