IREDELL COUNTY HEALTH DEPARTMENT

STATESVILLE 704-878-5305 MOORESVILLE 704-664-5281

IMPROVEMENT PERMIT / AUTHORIZATION TO CONSTRUCT / OPERATION PERMIT / EXISTING SYSTEM INSPECTION

PERMIT# 15290 PIN# 4764 74 3346 DATE 8-8-98

OWNER OR CONTRACTOR Burt Bell PHONE: Business _____ Home 872 1292

ADDRESS 178 Bell Farm Rd sta.

LOCATION 64 E TR Bell Fm TR Farmwood 1st Hse Rt.

SUBDIVISION Farmwood BLOCK / SECTION _____ LOT _____ LOT AREA 3.38 acres SITE CLASS PS DESIGN FLOW 360 L.T.A.R. .27

Septic Tank: 1000 Gallons; STB 1012 Date 2-3-99
Pump Tank: _____ Gallons; PT _____ Date _____
Pump Make: _____ Model _____ Serial No. _____
Nitrification Field: No Fields 1 Square Feet 1350 Linear Feet 450
No Lines 3 Trench Width 36 Max Trench Bottom Depth 36 Gravel Depth 12"

☑ New System ☐ Repair System Type: I, II, III, IV, V, VI
System Description: Conv. Gravity
Repair System Description: Pump To 25% Rct.
Maintenance Agreement Required: ☐ Yes ☑ No
☐ Slab ☐ Crawl Space ☑ Basement w/plumbing ☐ Basement wo/plumbing


☑ House/Mod. Home No. Bedrooms 3
☐ Mobile Home No. Bathrooms 4
☐ Business No. Employees _____
☐ Other _____

Water Supply: ☐ Individual ☑ Public ☐ Community


Comments:/Conditions:

Comments:/Conditions:

INITIAL SITE SKETCH

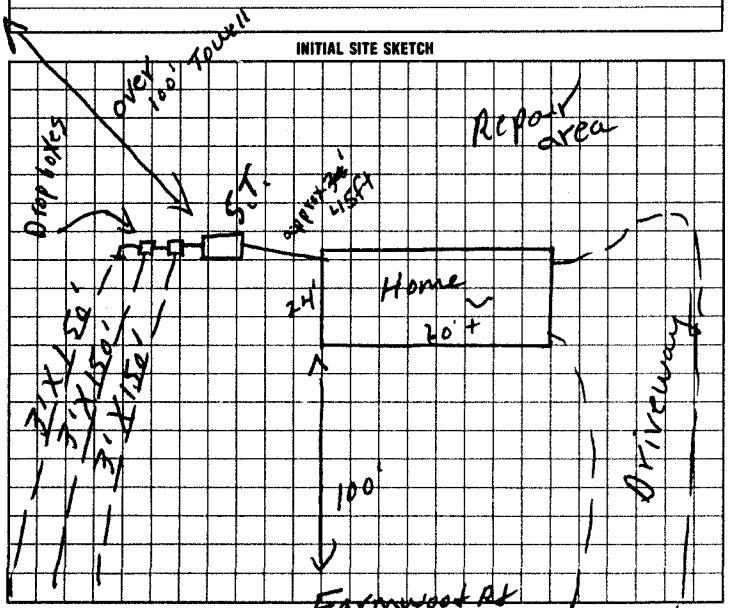

AS BUILT SKETCH

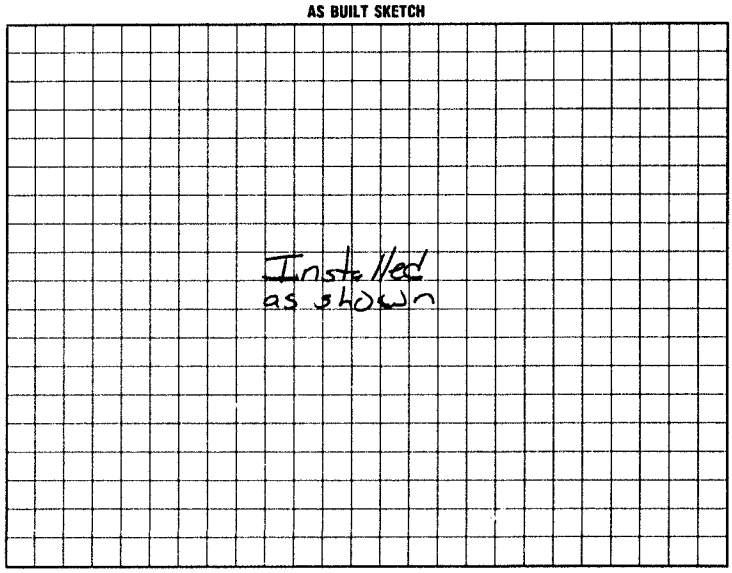

I understand that this permit can be suspended or revoked if any false information is supplied toward securing the permit/any unauthorized changes are made to the site/any unauthorized changes are made in the installation of the system. Improvement Permit with plat valid without expiration. Improvement Permit with site plan valid for sixty months. Authorization to Construct is valid for a period equal to that of Improvement Permit – not to exceed sixty months.

Signed: Nina Bell date _____ Installed by: Steve Jordan

Improvement Permit by: R. C. Moore date 8-8-98 Operation Permit by: [illegible] date 4-8-99

Authorization to Construct by: R. C. Moore date 8-8-98 Existing System Inspection by: _____ date _____

HEALTH DEPT. COPY: WHITE INSPECTION COPY (FINAL) GREEN OWNER COPY (FINAL) YELLOW INSPECTION COPY (INITIAL) PINK OWNER COPY (INITIAL) GOLD