IREDELL COUNTY HEALTH DEPARTMENT

STATESVILLE 704-878-5305 MOORESVILLE 704-664-5281

IMPROVEMENT PERMIT / AUTHORIZATION TO CONSTRUCT / OPERATION PERMIT / EXISTING SYSTEM INSPECTION

DATE 1-26-00

PERMIT# 87389 PIN# 4764983306

OWNER OR CONTRACTOR Archie Fletcher PHONE: Business 878 2314 Home

ADDRESS 119 meadows Ct, Statesville, N.C.

LOCATION 64E TR New Salem TR Pottery 1/2 way out on Rt.

SUBDIVISION BLOCK / SECTION LOT LOT AREA 33.49 acres SITE CLASS PS DESIGN FLOW 480 L.T.A.R. .125

Septic Tank: 1000 Gallons: STB 1012 Date 10-15-00
Pump Tank: Gallons: PT Date
Pump Make: Model Serial No.
Nitrification Field: No Fields 1 Square Feet 640 Linear Feet 1920
No Lines 5 Trench Width 36" Max Trench Bottom Depth 24"

☑ New System ☐ Repair System Type: I (II) III. IV. V. VI
System Description: Conv. Gravity
Repair System Description: Pump to conv.
Maintenance Agreement Required: ☐ Yes ☑ No


☑ House/Mod. Home No. Bedrooms 4/3
☐ Mobile Home No. Bathrooms
☐ Business No. Employees
☐ Other
☐ Slab ☐ Crawl Space ☑ Basement w/plumbing ☐ Basement wo/plumbing

Water Supply: ☑ Individual ☐ Public ☐ Community


Comments/Conditions: (Repair area)

Comments/Conditions: INSTALLED AS SHOWN WITH POLYCOIC FILTER & MARKER

INITIAL SITE SKETCH

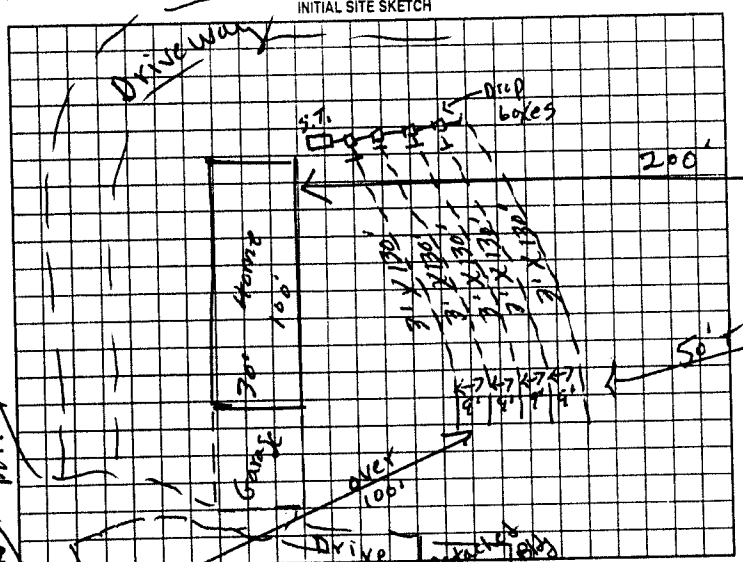

AS BUILT SKETCH

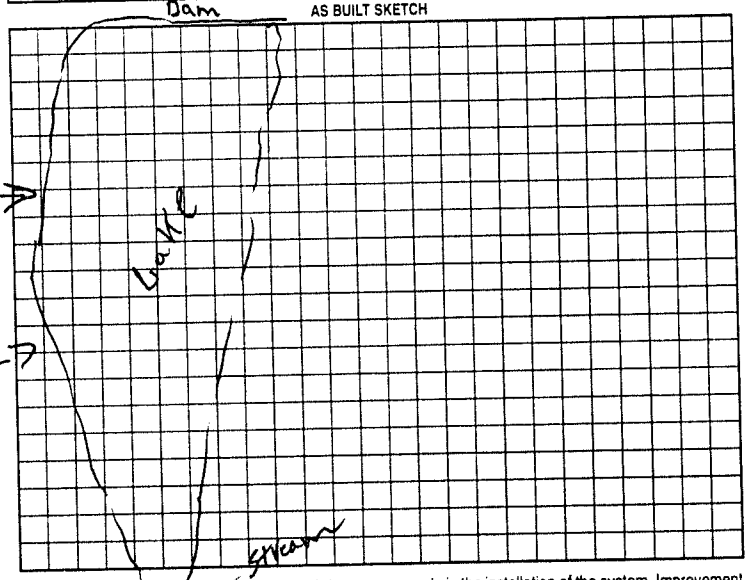

Permit can be suspended or revoked if any false information is supplied toward securing the permit/any unauthorized changes are made to the site/any unauthorized changes are made in the installation of the system. Improvement Permit with plat valid without expiration. Improvement Permit with site plan valid for sixty months. Authorization to Construct is valid for a period equal to that of Improvement Permit – not to exceed sixty months.

Signed: date 2-7-00

Improvement Permit by: P. C. Moore date

Authorization to Construct by: P. C. Moore date

Installed by: STEVE JORDAN

Operation Permit by: date 05-09-01

Existing System Inspection by: date

HEALTH DEPT. COPY: WHITE OWNER COPY (FINAL): YELLOW OWNER COPY (INITIAL): PINK