IREDELL COUNTY HEALTH DEPARTMENT

Statesville Phone TR 3-7271 Mooresville Phone NO 3-1271

PERMIT TO INSTALL SEPTIC TANK

Permit No. 48 Permit Date 5-11 19 72

Owner Buford Kerley Address 107 Augusta Dr. City

Installed By Harlee Lackey Address Stony Point N C


Location of Property Out East Broad St to Country Club Section T.R. on Augusta Drive - 1st House on left House Built By A. D. Lindsey

Tank		Capacity		Length of Lines		Fixtures	
Block	( )	1000	( )	225'	( )	No. of Baths	(2½)
Precast	(✓)	1250	(✓)	250'	( )	Dishwasher	(✓)
		1500	( )	Other 930 sq ft		Garbage Grdr.	(✓)
		Other				Other	

NOTIFY HEALTH DEPARTMENT AT LEAST EIGHT HOURS BEFORE TANK IS TO BE INSPECTED.

Final Inspection 5-11 19 72 Approved (✓) Disapproved ( )

Remarks Well in Front of House

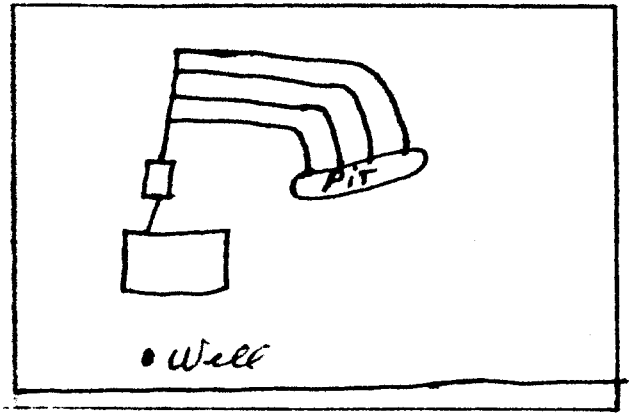

Sketch of Installation

Lines are deep due to stub out.

E. C. Stevenson

Sanitarian