Not on BK

IREDELL COUNTY HEALTH DEPARTMENT

Statesville Phone TR 3-7271 Mooresville Phone NO 3-1271

PERMIT TO INSTALL SEPTIC TANK

Permit NO. _____ Permit Date Feb 29 1972

Owner Mr H L Saunders Address Statesville N.C.

Installed By Sam Sanders Address Statesville N.C.


Location of Property Glen Eagle Rd in Country Club

Tank		Capacity		Length of Lines		Fixtures	
Block	( )	1000	( )	225'	( )	No. of Baths	(2)
Precast	(✓)	1250	(✓)	250'	( )	Dishwasher	(✓)
		1500	( )	Other 300 ft Li. 900 sq ft		Garbage Grdr.	(✓)
		Other				Other	

NOTIFY HEALTH DEPARTMENT AT LEAST EIGHT HOURS BEFORE TANK IS TO BE INSPECTED.

Final Inspection _____ Approved (✓) Disapproved ( )

Remarks _____

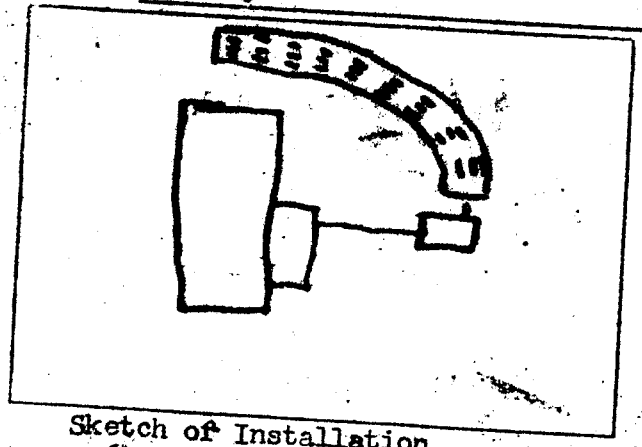

Sketch of Installation

L W Johnson R.S.

Sanitarian