IREDELL COUNTY HEALTH DEPARTMENT

Statesville Phone TR 3-7271 Mooresville Phone NO 3-1271

PERMIT TO INSTALL SEPTIC TANK

Permit NO. 53 Permit Date [illegible] 11 19 62

Owner Mr Ted Edwards Address Country Club

Installed By Raymond Adam Address Statesville N.C.,


Location of Property Country Club - 1st entrance - 1st rd to left. on rt -

Tank		Capacity		Length of Lines		Fixtures	
Block	( )	1000	( )	225'	( )	No. of Baths	(3)
Precast	( )	1250	(✓)	250'	( )	Dishwasher	(✓)
		1500	( )	Other 900 aff		Garbage Grdr.	( )
		Other				Other	

NOTIFY HEALTH DEPARTMENT AT LEAST EIGHT HOURS BEFORE TANK IS TO BE INSPECTED.

Final Inspection Aug 11 1962 Approved (✓) Disapproved ( )

Remarks

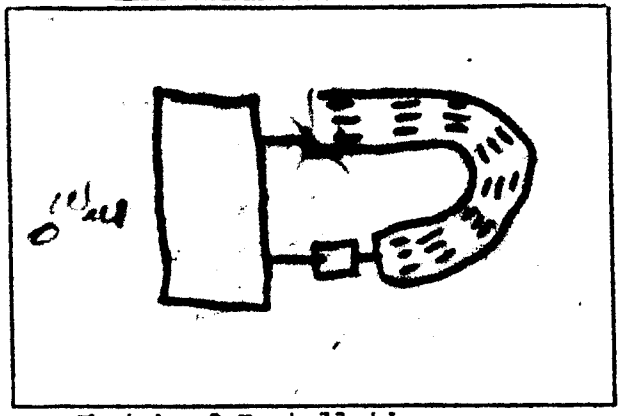

Sketch of Installation

R. W. Johnson RS

Sanitarian