IREDELL COUNTY HEALTH DEPARTMENT

Statesville Phone TR 3-7271 — Mooresville Phone NO 3-1271

PERMIT TO INSTALL SEPTIC TANK

Permit No. _____ Permit Date 9-30 19__

Owner I.V. Johnson Blds. Address Statesville, N.C.

Installed By Lackey Bros. Address Stony Point, N.C.


Location of Property Statesville Country Club section — St. Andrews Rd. on Rt.

Tank		Capacity		Length of Lines		Fixtures	
Block	( )	1000	( )	225'	( )	No. of Baths	(3½)
Precast	(✓)	1250	(✓)	250'	( )	Dishwasher	( )
		1500	( )	Other 300		Garbage Grdr.	( )
		Other _____		900 sq ft.		Other _____	

NOTIFY HEALTH DEPARTMENT AT LEAST EIGHT HOURS BEFORE TANK IS TO BE INSPECTED.

Final Inspection 9-30 1971 Approved (✓) Disapproved ( )

Remarks _____

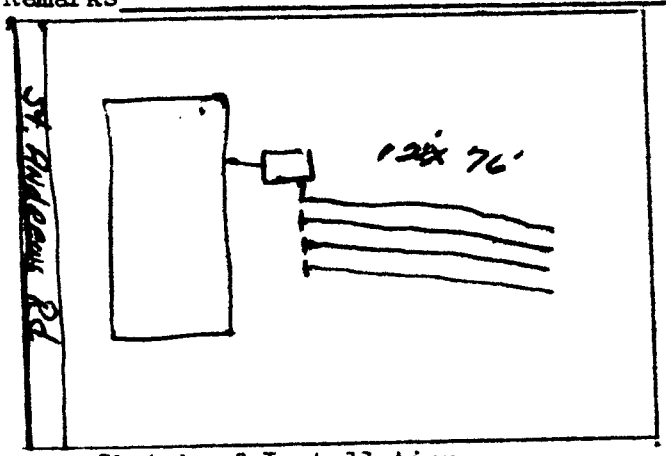

Sketch of Installation

No Rock Test Run - on Lot. Owners Responsibility

Sanitarian