IREDELL COUNTY HEALTH DEPARTMENT

Statesville Phone TR 3-7271 Mooresville Phone NO 3-1271

PERMIT TO INSTALL SEPTIC TANK

Permit No. 128 Permit Date 1-22 1971

Owner HOPE Bros. Address STATESVILLE, NC

Installed By Adams Septic Tank Service Address TAYLORSVILLE, NC


Location of Property HIGHWAY 64 E - TURN RIGHT 2ND Rd PAST CHATEN-NIBBLE - 2ND HOUSE ON RIGHT.

Tank		Capacity		Length of Lines		Fixtures	
Block	( )	1000	(✓)	225'	(✓)	No. of Baths	(1½)
Precast	(✓)	1250	( )	250'	( )	Dishwasher	( )
		1500	( )	Other		Garbage Grdr.	( )
		Other				Other	

NOTIFY HEALTH DEPARTMENT AT LEAST EIGHT HOURS BEFORE TANK IS TO BE INSPECTED.

Final Inspection 1-22 1971 Approved (✓) Disapproved ( )

Remarks TREE too Close to Drain Field

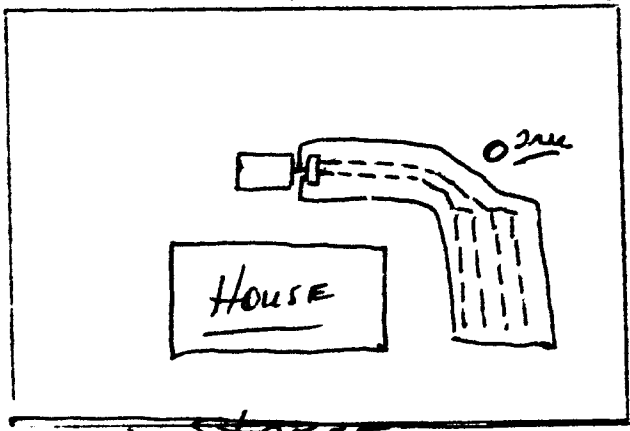

Sketch of Installation

Sanitarian