IREDELL COUNTY HEALTH DEPARTMENT

Statesville Phone TR 3-7271 Mooresville Phone NO 3-1271

PERMIT TO INSTALL SEPTIC TANK

Permit No. 177 Permit Date 1-22 1971

Owner Hope Bros. Builders Address Statesville, NC

Installed By Adams Septic Tank Service Address Taylorsville, NC


Location of Property Highway 64 E. Turn Right 2nd Road past Chat-N-Nibble. House on corner on Right.

Tank		Capacity		Length of Lines		Fixtures	
Block	( )	1000	(✓)	225'	(✓)	No. of Baths	(1½)
Precast	(✓)	1250	( )	250'	( )	Dishwasher	( )
		1500	( )	Other		Garbage Grdr.	( )
		Other				Other	

NOTIFY HEALTH DEPARTMENT AT LEAST EIGHT HOURS BEFORE TANK IS TO BE INSPECTED.

Final Inspection 1-22 1971 Approved (✓) Disapproved ( )

Remarks

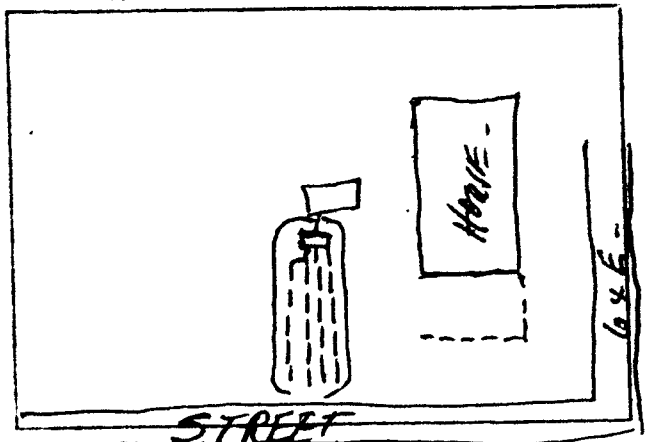

Sketch of Installation

Glenn Ford

Sanitarian