IREDELL COUNTY HEALTH DEPARTMENT

STATESVILLE 704-878-5305 MOORESVILLE 704-664-5281 (4)

IMPROVEMENT PERMIT / AUTHORIZATION TO CONSTRUCT / OPERATION PERMIT / EXISTING SYSTEM INSPECTION

PERMIT# 120318 PIN# 4765-04-6322 DATE 6-5-04

OWNER OR CONTRACTOR ROBERT SHARPE CONSTRUCTION PHONE: Business 704-902-4633 Home

ADDRESS RHA OF NC, INC, 3060 PEACHTREE RD, SUITE 620, ATLANTA, GA 30305

LOCATION US 64 EAST, 4TH LOT ON RIGHT PAST ROGER DRIVE

SUBDIVISION BLOCK / SECTION LOT LOT AREA LIMITED SITE CLASS. PS DESIGN FLOW 720 L.T.A.R. EXISTING

Septic Tank: 1500 Gallons; STB Date

Pump Tank: Gallons; PT Date

Pump Make: Model Serial No.

Nitrification Field: No Fields 1 Square Feet 1710+ Linear Feet 570

No Lines 3 BEDS Trench Width Max Trench Bottom Depth Gravel Depth 12"

☒ New System ☐ Repair System Type: I, II, III, IV, V, VI

System Description: CONVENTIONAL, GRAVITY

Repair System Description:

Maintenance Agreement Required: ☐ Yes ☒ No

☒ House/Mod. Home No. Bedrooms 6

☐ Mobile Home No. Bathrooms 2

☐ Business No. Employees

☐ Other

☐ Slab ☒ Crawl Space ☐ Basement w/plumbing ☐ Basement wo/plumbing


Water Supply: ☐ Individual ☒ Public ☐ Community

Comments:/Conditions:

Comments:/Conditions: REPLACE EXISTING BEDROOM AS SHOWN, SYSTEM FUNCTIONING PROPERLY AT TIME OF INSPECTION.

INITIAL SITE SKETCH

AS BUILT SKETCH NOT TO SCALE

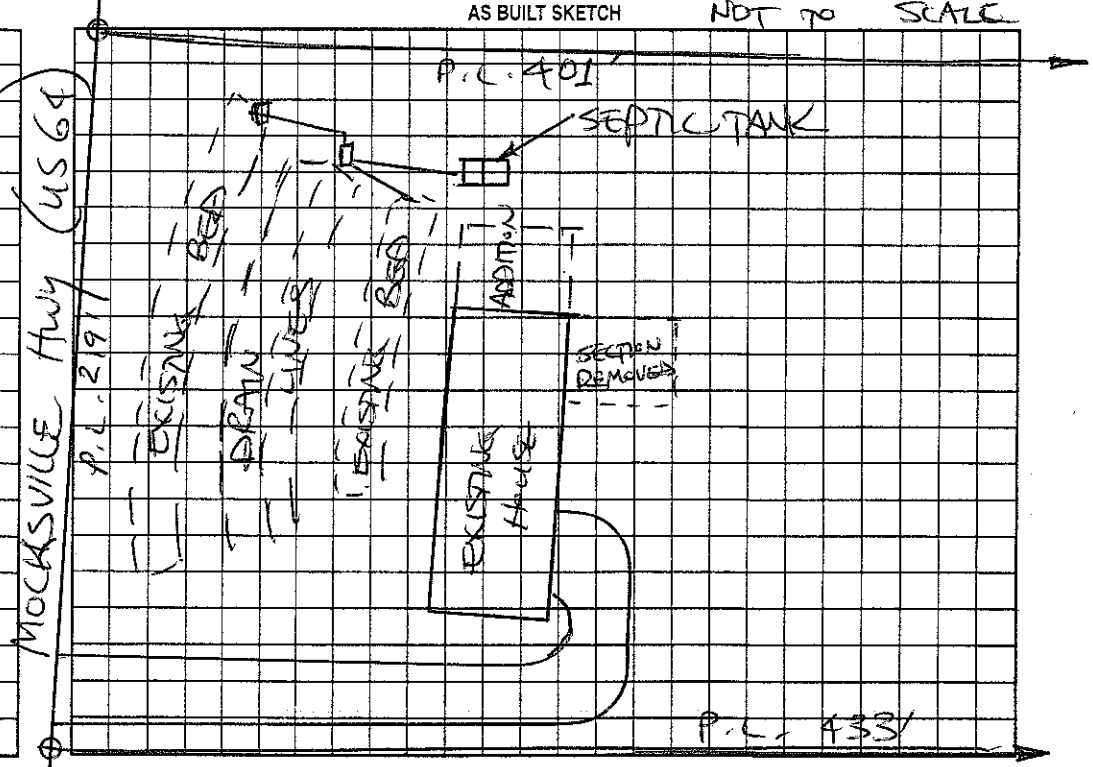

Permit can be suspended or revoked if any false information is supplied toward securing the permit/any unauthorized changes are made to the site/any unauthorized changes are made in the installation of the system. Improvement Permit with plat valid without expiration. Improvement Permit with site plan valid for sixty months. Authorization to Construct is valid for a period equal to that of Improvement Permit – not to exceed sixty months.

Signed: date Installed by:

Improvement Permit by: date Operation Permit by: date

Authorization to Construct by: date Existing System Inspection by: STEVE HENRICK date 6-5-04

HEALTH DEPT. COPY: WHITE OWNER COPY (FINAL): YELLOW OWNER COPY (INITIAL): PINK