IREDELL COUNTY HEALTH DEPARTMENT - *ENVIRONMENTAL HEALTH* ☒ STATESVILLE OFFICE 704-878-5305 ☐ MOORESVILLE OFFICE 704-664-5281

IMPROVEMENT PERMIT / AUTHORIZATION TO CONSTRUCT / OPERATION PERMIT / EXISTING SYSTEM INSPECTION

PERMIT # Existing PIN # 4765 04 8118 DATE 10-3-11

OWNER Peter Fritsch APPLICANT: Greg Dull Builders PHONE: Home/Cell # Business #

SITE ADDRESS 317 Camelot Dr. Statesville OWNER / APPLICANT ADDRESS

SITE DIRECTIONS I-40 W TR 64 E. TR E. Broad Ext. < ¼ mile TR Camelot on Right in sharp curve

SUBDIVISION Camelot BLOCK / SECTION LOT # 17 LOT AREA DESIGN FLOW 360gpd L.T.A.R.

Septic Tank Existing Gallons: STB Date

Pump Tank Gallons: P T Date

Pump Make Model Serial #

No. Nitrification Fields: 1 No. Lines Linear Feet

Trench Width Existing Max. Trench Bottom Depth Gravel Depth

☐ New System ☐ Repair ☐ Expansion System Type I II III IV V VI

System Description: Existing System

Repair System Description:

Maintenance Agreement Required ☐ YES ☐ NO

☒ GRAVITY ☐ PRESSURE

☑ Residence No. Bedrooms 3

☐ Business No. Persons

☐ Other No. Employees

☐ Slab ☐ Crawl Space

☐ Basement w/plumbing ☐ Basement w/o plumbing

Water Supply


☐ Private

☒ Public

☐ Community

Comments / Conditions Existing septic system not showing ANY sign of malfunction & Non-bedroom Addition to House

INITIAL SITE SKETCH

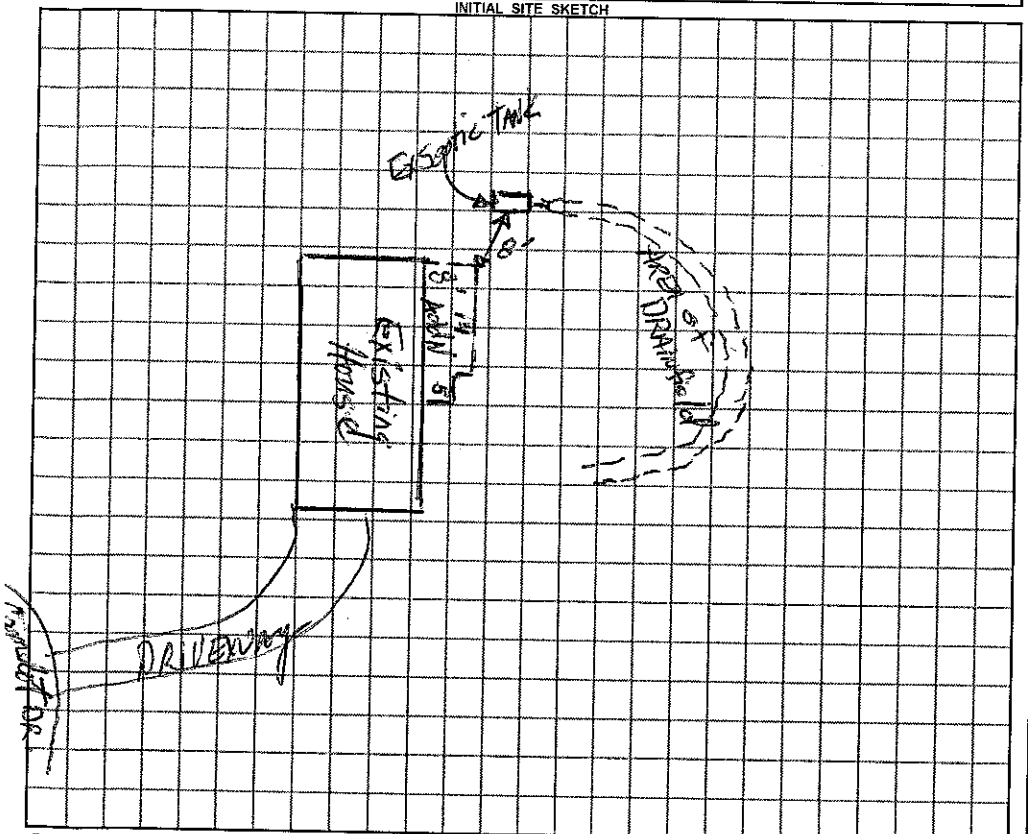

AS BUILT SKETCH

Permit can be suspended or revoked if any false information is supplied toward securing the permit / any unauthorized changes are made to the site / any unauthorized changes are made in the installation of the system.

☐ ***IMPROVEMENT PERMIT*** with plat valid without expiration. ☐ ***IMPROVEMENT PERMIT*** with plat valid without expiration. site plan valid 60 mo. ☐ ***AUTHORIZATION TO CONSTRUCT*** valid for period equal to IMPROVEMENT PERMIT--not to exceed 60 mo.

Owner / Applicant Signature: Date 10-3-11 Installed by:

IMPROVEMENT PERMIT by: ***REHS*** Date OPERATION PERMIT by: ***REHS*** Date

AUTHORIZATION TO CONSTRUCT by: ***REHS*** Date Existing System Inspected by: ***REHS*** Date 10-3-11

YOU SHOULD CONTACT A LOCATOR SERVICE PRIOR TO ANY EXCAVATION

White Copy – Environmental Health YELLOW COPY (Final) Owner / Applicant PINK COPY (Initial) Owner / Applicant