IREDELL COUNTY HEALTH DEPARTMENT

Statesville Phone TR 3-7271 Mooresville Phone NO 3-1271

PERMIT TO INSTALL SEPTIC TANK

Permit NO. _____ Permit Date July 12 19 63

Owner Bill winters Address Shannon Acres

Installed By C Hoke Address 127


Location of Property 2nd hard to right off E. Brd. Ext. 3/4 mile on left. 2 story brick and frame

Tank	Capacity	Length of Lines	Fixtures
Block ( )	800 ( )	150' ( )	No. of Baths (5)
Precast (✓)	900 ( )	175' ( )	Dishwasher ( )
	1000 ( )	200' ( )	Garbage Grdr. ( )
	1100 ( )	225' ( )	Auto-Washer (✓)
	1200 ( )	250' ( )	Other _____
	Other 1250	Other 300'	

NOTIFY HEALTH DEPARTMENT AT LEAST EIGHT HOURS BEFORE TANK IS TO BE INSPECTED.

Final Inspection 7-12 1963 Approved (✓) Disapproved ( )

Remarks Well 300'

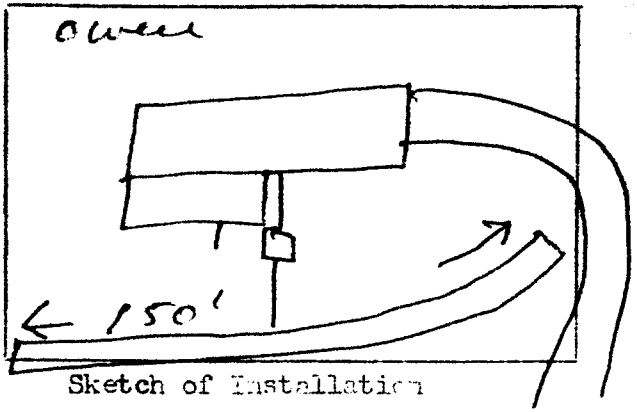

Sketch of Installation

Rat

Sanitarian