IREDELL COUNTY HEALTH DEPARTMENT

Statesville Phone TR 3-7271 Mooresville Phone NO 3-1271

PERMIT TO INSTALL SEPTIC TANK

Permit NO. 325 — Carl Bass Bldr. Permit Date Sept. 23 1970

Owner MR. DAN KAY Address STATESVILLE, N.C.

Installed By Adams Septic Tank Ser Address TAYLORSVILLE, N.C.


Location of Property Country Club. EAST ON GLEN EAGLES Road. ON LEFT.

Tank		Capacity		Length of Lines		Fixtures	
Block	( )	1000	( )	225'	( )	No. of Baths	(3)
Precast	(✓)	1250	(✓)	250'	( )	Dishwasher	(1)
		1500	( )	Other 270		Garbage Grdr.	(1)
		Other				Other	

NOTIFY HEALTH DEPARTMENT AT LEAST EIGHT HOURS BEFORE TANK IS TO BE INSPECTED.

Final Inspection Sept. 23 1970 Approved (✓) Disapproved ( )

Remarks

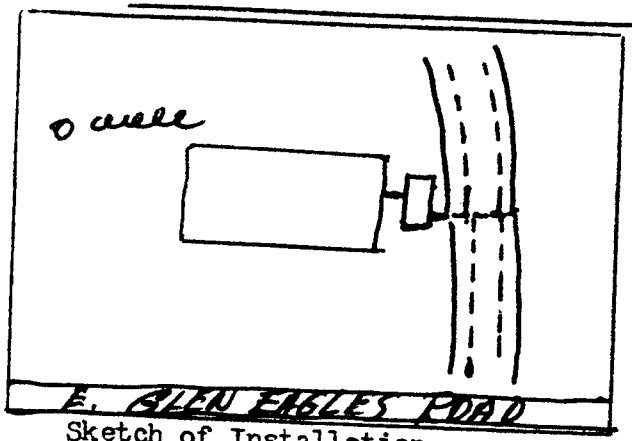

Sketch of Installation

Glenn Todd

Sanitarian