IREDELL COUNTY HEALTH DEPARTMENT

Statesville Phone TR 3-7271 Mooresville Phone No. 664-5281

PERMIT TO INSTALL SEPTIC TANK

Permit No. 611 Permit Date 8-24 1973

Owner KALMAN Garden Address St Andrews Rd

Installed By HARLEE LACKEY Address STONY POINT, NC


Location of Property Statesville Country Club.
St. Andrews Rd

Tank		Capacity		Length of Lines		Fixtures	
Block	( )	1000	( )	225'	( )	No. of Baths	(5)
Precast	(✓)	1250	(✓)	250'	( )	Dishwasher	(✓)
		1500	( )	Other 375		Garbage Grdr.	(✓)
		Other				Other	

CALL HEALTH DEPARTMENT AT LEAST EIGHT HOURS BEFORE TANK IS TO BE INSPECTED.

Final Inspection 8-24 1973 Approved (✓) Disapproved ( )

Remarks

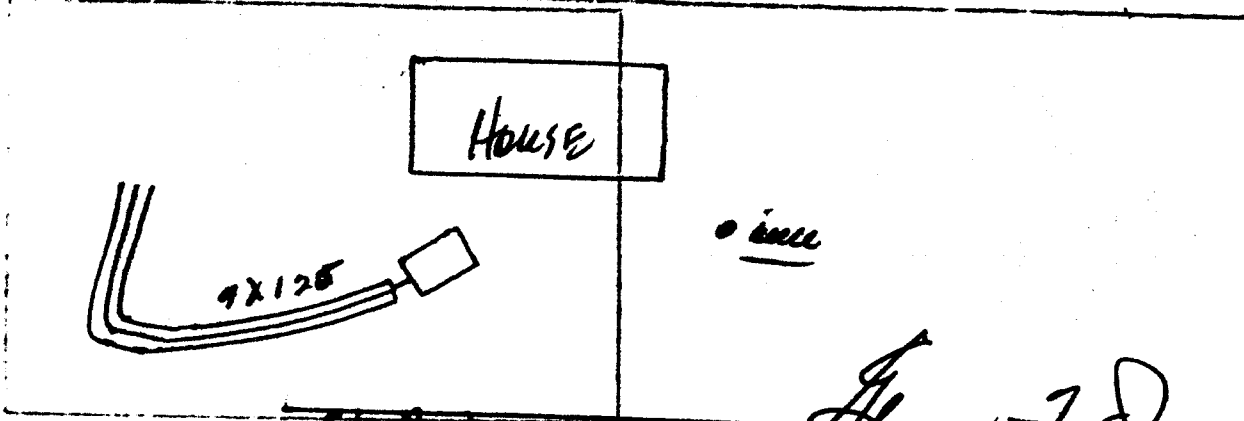

Sketch of Installation

Sanitarian