IREDELL COUNTY HEALTH DEPARTMENT

Statesville Phone TR 3-7271 Mooresville Phone NO 3-1271

PERMIT TO INSTALL SEPTIC TANK

Permit NO. _____ Permit Date Jan 18 19 64

Owner Bobbie Poole (cont) Address Statesville

Installed By Roy Long Address Statesville

Location of Property Brookmede Sub Division


Dog Right

Tank		Capacity		Length of Lines		Fixtures	
Block	( )	800	( )	150'	( )	No. of Baths	(1½)
Precast	( )	900	( )	175'	( )	Dishwasher	( )
Pour		1000	(✓)	200'	( )	Garbage Grdr.	( )
		1100	( )	225'	(✓)	Auto-Washer	(✓)
		1200	( )	250'	( )	Other	
		Other		Other			

NOTIFY HEALTH DEPARTMENT AT LEAST EIGHT HOURS BEFORE TANK IS TO BE INSPECTED.

Final Inspection 1-18 19 64 Approved (✓) Disapproved ( )

Remarks Owner

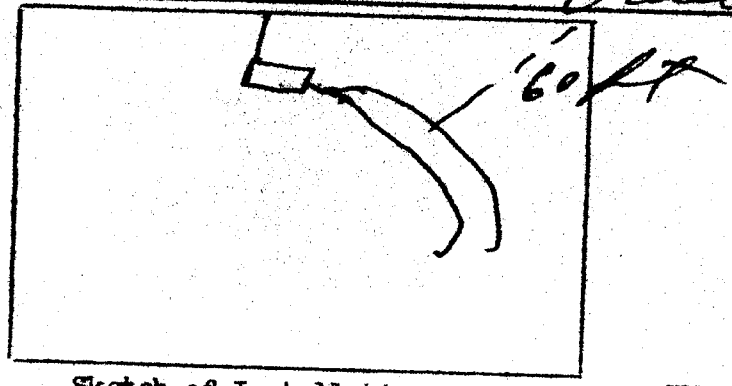

Sketch of Installation

Sanitarian