IREDELL COUNTY HEALTH DEPARTMENT

Statesville Phone TR 3-7271 Mooresville Phone NO 3-1271

PERMIT TO INSTALL SEPTIC TANK

Permit NO. _____ Permit Date Jan 31 1961

Owner Carl Bush Address E. Brd. Ext

Installed By C Hoke Address R7


Location of Property Split Level on right in County Club Estates.

Tank	Capacity	Length of Lines	Fixtures
Block ( )	800 ( )	150' ( )	No. of Baths ( )
Precast (✓)	900 ( )	175' ( )	Dishwasher ( )
Bush	1000 (✓)	200' ( )	Garbage Grdr. ( )
	1100 ( )	225' ( )	Auto-Washer ( )
	1200 ( )	250' ( )	Other _____
	Other _____	Other 255'	

NOTIFY HEALTH DEPARTMENT AT LEAST EIGHT HOURS BEFORE TANK IS TO BE INSPECTED.

Final Inspection Jan 31 1961 Approved (✓) Disapproved ( )

Remarks Very heavily wooded - Self op.

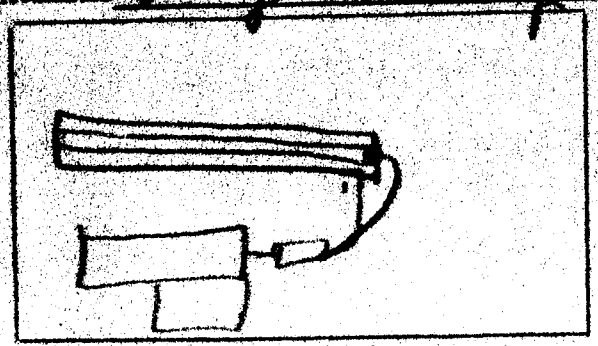

Sketch of Installation

R. A. 2.

Sanitarian