IREDELL COUNTY HEALTH DEPARTMENT

Statesville Phone TR 3-7277 — Mooresville Phone NO 3-1271

PERMIT TO INSTALL SEPTIC TANK

Permit NO. _____ Permit Date Dec 15 — 1960

Owner Allen Johnson - Parker Address New Country Club

Installed By _____ Address Rt 7-


Location of Property 2nd paved street to right 1st dirt to left - 1st on left -

Tank		Capacity		Length of Lines		Fixtures	
Block	( )	800	( )	150'	( )	No. of Baths	(2)
Precast	(✓)	900	( )	175'	( )	Dishwasher	(✓)
Lock		1000	( )	200'	( )	Garbage Grdr.	(✓)
		1100	( )	225'	( )	Auto-Washer	(✓)
		1200	( )	250'	( )	Other	_____
		Other 1250		Other 300'			

NOTIFY HEALTH DEPARTMENT AT LEAST EIGHT HOURS BEFORE TANK IS TO BE INSPECTED.

Final Inspection Dec 15 1960 Approved (✓) Disapproved ( )

Remarks Very deep - narrow place to put lines -

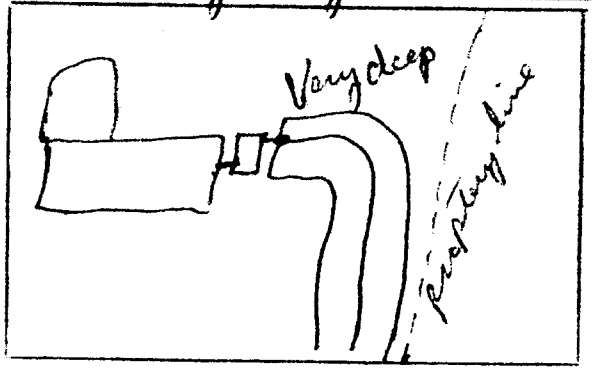

Sketch of Installation

Checked by R. Thomas

Sanitarian