IREDELL COUNTY HEALTH DEPARTMENT

Statesville Phone TR 3-7271 Mooresville Phone NO 3-1271

PERMIT TO INSTALL SEPTIC TANK

Permit No. 262 Permit Date Aug. 6 19 70

(Jerry Burns)

Owner Isenhour Building Co. Address Statesville, N.C.

Installed By Adams Septic Tank Service Address Taylorsville, N.C.


Location of Property East Broad St. Ext. Turn Right on Road # 2443 (Brookmeade) 2nd House on Right.

Tank		Capacity		Length of Lines		Fixtures	
Block	(✓)	1000	( )	225'	( )	No. of Baths	(3)
Precast	(✓)	1250	(✓)	250'	( )	Dishwasher	(1)
		1500	( )	Other 270		Garbage Grdr.	(1)
		Other				Other	

NOTIFY HEALTH DEPARTMENT AT LEAST EIGHT HOURS BEFORE TANK IS TO BE INSPECTED.

Final Inspection Aug 6 19 70 Approved (✓) Disapproved ( )

Remarks

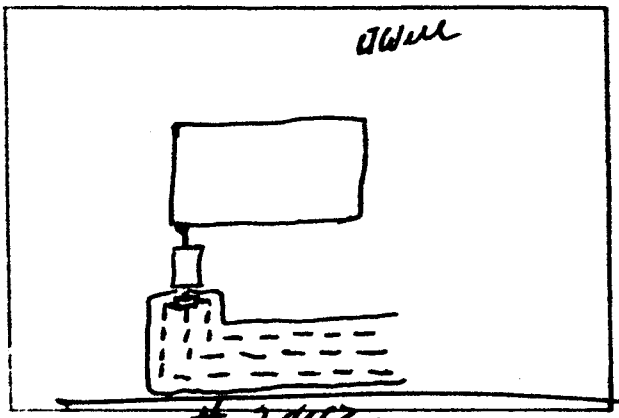

Sketch of Installation

Sanitarian