IREDELL COUNTY HEALTH DEPARTMENT

(SEPTIC TANK) IMPROVEMENTS PERMIT AND CERTIFICATE OF COMPLETION
(Ground Absorption Sewage Disposal System - G. S. Chapter 130-Article 13C)

OWNER OR CONTRACTOR Ronald K. Walters DATE 3-22-90 PERMIT NO. _____

PHONE: Business _____ Home _____

LOCATION 3321 winchester S. R. No. _____

SUBDIVISION NAME _____ LOT NO. _____ SECTION OR BLOCK NO. _____

House (✓) Mobile Home ( ) Business ( ) Other Repair


No. Bedrooms _____ No. Bathrooms _____

Garbage Disposal Unit	Yes ( )	No ( )
Auto. Dishwasher	Yes ( )	No ( )
Auto. Wash. Machine	Yes ( )	No ( )
Site Suitable	Yes ( )	No ( )

Character & Porosity of Soil Clayey
Percolation Rate 2
Topography Sloped
Depth to Water Table 10'+
Rock or other impervious formations none

Lot Area _____

_____ Basement with Plumbing _____ Basement without Plumbing _____ No Basement

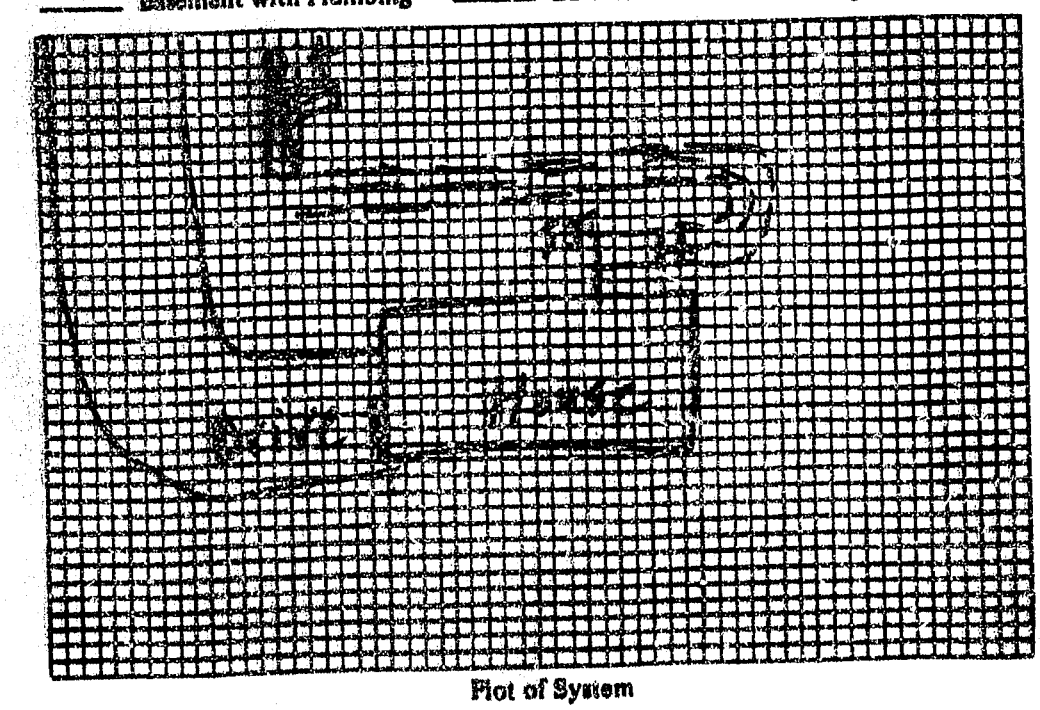

Plot of System

Size of Tank Existing Gals.
Nitrification Field:
No. of Lines _____
Sq. Ft. _____ Linear Ft. _____
Depth of Stone in Lines _____
Water Supply: Individual ( )
Public ( )
1T Ton Pit

Installed by Johnnie Mercer

I understand and agree to install septic tank system as specified on this Improvements Permit.

Signed: _____

IMPROVEMENTS PERMIT BY L. C. Moore

COMMENTS: At owners request Pit only was installed Drain line to be added later if necessary.

CERTIFICATE OF COMPLETION BY L. C. Moore DATE 3-22-90

EXISTING SYSTEM CHECKED BY: _____ DATE _____

CONSTRUCTION MUST COMPLY WITH ALL OTHER APPLICABLE STATE AND LOCAL REGULATIONS.

Permit is VOID if any unauthorized changes are made in installation of system and/or if any false information is supplied in making Improvements Permit.

Health Dept. Copy: White Inspection Dept. Copy: Yellow Sanitarian's Copy: Pink Owner's Copy: Gold